

MICHIGAN  
DEPARTMENT OF CONSERVATION  
FORESTRY DIVISION

# LAND CORNER RECORD

T. 42 N.R. 12 W


Mackinac COUNTY

DESCRIPTION OF CORNER Sec. Cor. common to Secs. 7-8-17-18.

CORNER MONUMENT 1" pipe with 4" Aluminum Cap.

DATE MONUMENT PLACED AND WITNESSED 8-13-69

WITNESSES TO CORNER..... 14" Soft Maple (S18 NBT) S 40°W 6.7'

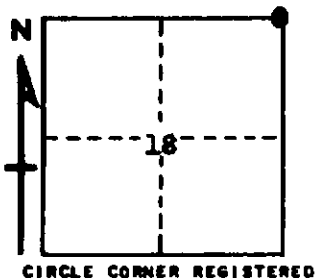

12" Cedar (S7 NBT) N65°W 17.6'

5" Cedar (S8 NBT) N87°E 6.0'

AND

DESCRIPTION IN DETAIL AS TO HOW CORNER WAS LOCATED AND IDENTIFIED OR RESTORED.

This corner replaced from one original Cedar witness, bearing N87°E, 34 Links. Stump is in poor condition. Found remains of bottom blaze and notch with calloused overgrowth. Found a Cedar with old blaze facing corner location.

SURVEYOR'S SEAL

SIGNED Billy D. Buckler DATE 1-12-70  
REGISTERED LAND SURVEYOR