

MICHIGAN
DEPARTMENT OF CONSERVATION
FORESTRY DIVISION

LAND CORNER RECORD

T. 42 N.R. 12 W


Mackinac COUNTY

DESCRIPTION OF CORNER 1/4 Cor. bet. Secs. 2-11.

CORNER MONUMENT 1" Pipe with 1/4" Aluminum Cap.

DATE MONUMENT PLACED AND WITNESSED 10-22-69

WITNESSES TO CORNER..... 16" W. Birch (1/8 NBT) S48°E 6.7'

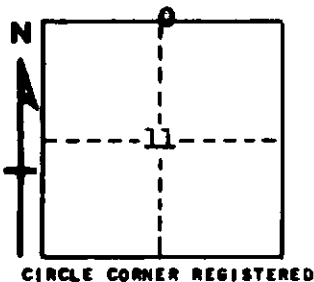

AND

DESCRIPTION IN DETAIL AS TO HOW CORNER WAS LOCATED AND IDENTIFIED OR RESTORED.

This corner replaced at an old squared post, placed by unknown persons. Corner location has been perpetuated since before 1940. Found no evidence of original witnesses.

Corner lies 14' North of an old camp bottom and 20' West of a woods road.

SURVEYOR'S SEAL

SIGNED Billy D. Buckler DATE 1-12-70
REGISTERED LAND SURVEYOR