

**LAND CORNER RECORDATION CERTIFICATE**  
**Filing Requirement of Act 74, Mich. P.A. 1970**

For corners in

Mackinac

(County)

Located In:

Corner Code #

1. Public Land Survey	T	R	_____
	T	R	_____
	T	R	_____
	T	R	_____
2. Property Controlling in Section	S <u>29</u>	T <u>42N</u> R <u>12W</u>	<u>10</u>
	S <u>29</u>	T <u>42N</u> R <u>12W</u>	<u>2</u>
3. Miscellaneous Property in Sec.	S	T	R
	S	T	R

Register of Deeds Stamp & File Number

4. Lot No. \_\_\_\_\_, Recorded Plat \_\_\_\_\_  
 5. Private Claims \_\_\_\_\_

May 08 2002

I, Stephan J. Szyszkoski, in a field survey on \_\_\_\_\_, 20\_\_ do hereby state that under requirements of P.A. 74, Michigan P.A. of 1970, the corner points mentioned in lines 1 and 2 above were in conformance with regulations and rules therefore as required in the current manual of survey instructions of the United States Department of the Interior, Bureau of Land Management or by a decree of a Court of Law and /or that the corner points mentioned in lines 3, 4 and 5 above were in conformance with the rules of the Michigan Board of Land Surveyors or by a Decree of a Court of Law, established, re-established, monumented, recovered, found as expressed below:

**NOTE:** Not more than 2 corners, all in the same town and range, may be recorded on this certificate.

	A	B	C	D	E	F	G	H	I	J	K	L	M
1													
2		6		5		4		3		2		1	
3													
4		7		8		9		10		11		12	
5													
6		10		17		16		15		14		13	
7													
8		19		20		21		22		23		24	
9													
10		30		29		28		27		26		25	
11													
12		31		32		33		34		35		36	
13													


**A. Description of original monument and accessories and/or subsequent restoration:**  
 (10-Sec. 29) South 1/16 corner between Sections 29 and 30. Not established in the original survey. Found no subsequent record.  
 (2-Sec. 29) East 1/16 corner between Sections 20-29. Not established in the original survey. Found no subsequent record.

**B. Description of corner evidence found and/or method applied in restoring or reestablishing corner:**

(10-Sec. 29) Established the corner midway and on a line of mean true bearing between Quarter and Section corners of record 1322.89' north and south, respectively. From the corner thus established, I found an 8" squared balsam for an approximate corner, marked by unknown persons, S88W 28' distant.  
 (2-Sec. 29) Established the corner midway and on a line of mean true bearing between Quarter and Section corners of record 1306.73' west and east, respectively.

**C. Description of monument for corner and accessories established to perpetuate locating the position of the corner:**

(10) Set 1"IDx36" I.pipe with 4" alum. MDNR cap. Blazed, scribed, and set measuring nails in: 8" Cedar N84W 1.85'      "S1/16 BT" 8" Cedar S39E 2.75'      do 10" Cedar N25E 14.35'      do 10" Cedar S48E 5.1'      do Bearings are magnetic. Distances are to nail with tag.	(2) Set 1"IDx36" I.pipe with 4" alum. MDNR cap. Blazed, scribed, and set measuring nails in: 6" Cedar S85E 9.25'      "E1/16 BT" 10" Cedar S65W 19.25'      do 8" Twin Cedar N79W 33.65'      do 10" Cedar N40W 35.8'      do Set cedar post adjacent. Bearings are magnetic. Distances are to nail with tag.
---	--

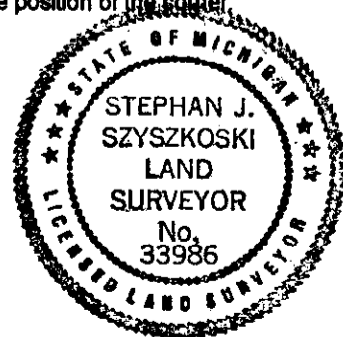

Signed by Stephan J. Szyszkoski  
 Surveyor's Michigan License No. 33986

Date 8/13/02