

LAND CORNER RECORDATION CERTIFICATE
Filing Requirement of Act 74, Mich. P.A. 1970

For corners in

Mackinac

(County)

Located In:

Corner Code #

1. Public Land Survey	T <u>42N</u> R <u>12W</u>	<u>C9</u>
	T <u>42N</u> R <u>12W</u>	<u>E11</u>
	T <u> </u> R <u> </u>	<u> </u>
	T <u> </u> R <u> </u>	<u> </u>
2. Property Controlling in Section	S <u> </u> T <u> </u> R <u> </u>	<u> </u>
	S <u> </u> T <u> </u> R <u> </u>	<u> </u>
3. Miscellaneous Property in Sec.	S <u> </u> T <u> </u> R <u> </u>	<u> </u>
	S <u> </u> T <u> </u> R <u> </u>	<u> </u>

Register of Deeds Stamp & File Number

4. Lot No. _____, Recorded Plat _____
 5. Private Claims _____

Apr 30 2002

I, Stephan J. Szyszkoski, in a field survey on _____, 20____ do hereby state that under requirements of P.A. 74, Michigan P.A. of 1970, the corner points mentioned in lines 1 and 2 above were in conformance with regulations and rules therefore as required in the current manual of survey instructions of the United States Department of the Interior, Bureau of Land Management or by a decree of a Court of Law and/or that the corner points mentioned in lines 3, 4 and 5 above were in conformance with the rules of the Michigan Board of Land Surveyors or by a Decree of a Court of Law; established, re-established, monumented, recovered, found as expressed below:

NOTE: Not more than 2 corners, all in the same town and range, may be recorded on this certificate.

	A	B	C	D	E	F	G	H	I	J	K	L	M
1													
2		6		5		4		3		2		1	
3													
4		7		8		9		10		11		12	
5													
6		18		17		16		15		14		13	
7													
8		19		20		21		22		23		24	
9													
10		30		29		28		27		26		25	
11													
12		31		32		33		34		35		36	
13													

A. Description of original monument and accessories and/or subsequent restoration:


(C9) Corner common to Sections 19-20-29-30. 1959: Record of Billy D. Buckler RLS: Cor. lies on east edge of old N-S grade. Found old blaze on Cedar on westside grade. Checks to str. and swp. edge north. Cor. lies on a straight line with sec. cors. east and west. Cor. placed and wit. 6/5/59 with B. McDonald, Aide. 1" pipe with 4" brass cap. 9" Cedar N5E 09 links, 7" Cedar S18E 18 links, 8" Cedar S32W 32 links.
 (E11) Corner common to Sections 28-29-32-33. 1959: Reestablished by double proportionate measurement by Billy D. Buckler RLS. 1" pipe with 4" brass cap. 6" Hard Maple S32W 30 links, 6" Hard Maple S70E 56.5 links, 6" Hard Maple N72W 10.5 links.

B. Description of corner evidence found and/or method applied in restoring or reestablishing corner:

(C9) Recovered the 1959 monument in good condition, at record bearing and distance from the remaining Cedar NBTs NE and SE. The Cedar NE is in good condition. That SE has been cut off 3' high, with top blaze still visible. My measurements show that this monument is 24' south of a straight line between Section corners east and west, contrary to the 1959 record. Distance south to an original corner, however, checks well with the original record. I accept the monument as the best available evidence of the position of the original corner.
 (E11) Recovered the 1959 monument in good condition and at record bearing and distance from all three NBTs, in good condition. Left the monument in place, marked the NBTs with a new top blaze and made one new witness as described below.

C. Description of monument for corner and accessories established to perpetuate locating the position of the corner:

(C9) Found 1" ID I. pipe with 4" brass cap. Blazed, scribed, and set measuring nails in:	(E11) Found 1" ID I. pipe with 4" brass cap. Blazed, scribed, and set measuring nails in:
18" Cedar (1959 NBT) N13E 6.2' "S20"	10" Sugar S35W 19.45' "S32"
10" Y. Birch S10E 8.6' "S29 NBT"	10" Sugar S72E 37.35' "S33"
8" Cedar S83W 21.8' "S30 NBT"	12" Sugar N70W 7.0' "S29"
10" Cedar S84E 24.3' "S29 NBT"	8" Sugar N40E 27.6' "S28 NBT"
Bearings are magnetic. Distances are to nail with tag.	Bearings are magnetic. Distances are to nail with tag.

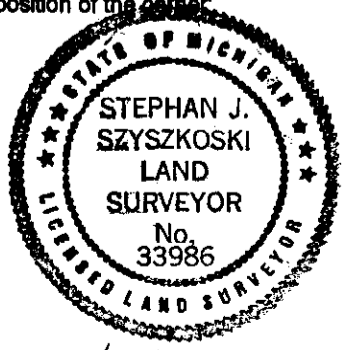

Signed by Stephan J. Szyszkoski
 Surveyor's Michigan License No. 33986

Date 8/13/02