SURVEY & REMONUMENTATION

MAR 13 1998

SECTION

MACKINAC COUNTY REMONUMENTATION CORNER

LAND CORNER RECORDATION CERTIFICATE

Filing Requirement of Act 74, Mich. P.A. 1970

For corners in

Mackinac (County)

RECEIVED & FILED
DIANE FRANKOVICH
MACKINAC COUNTY REGISTER OF DEEDS
DEC 29 1997
AM PM

Register of Deeds Stamp & File Number

	Located In:	Corner Code #
1. Public Land Survey	T 42N R 3W	M-4
	T___ R___	E¼ Cor, Sec 12
	T 42N R 2W	A-4
	T___ R___	W¼ Cor, Sec 7
2. Property Controlling in Section	S___ T___ R___	
	S___ T___ R___	
3. Miscellaneous Property in Sec.	S___ T___ R___	
	S___ T___ R___	

4. Lot No. _____ , Recorded Plat _____

5. Private Claims _____

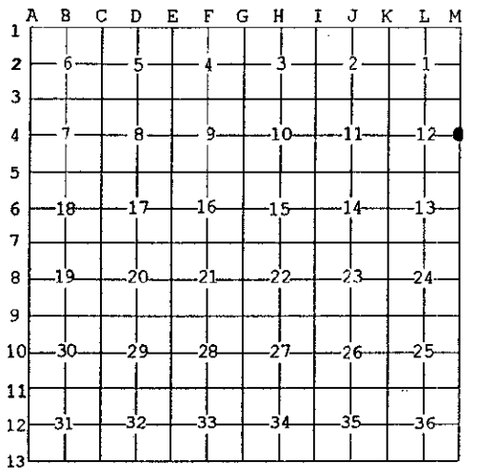

I, Neil E. Hill, in a field survey on DEC. 22, 19 97 do hereby state that under requirements of P.A. 74, Michigan P.A. of 1970, the corner points mentioned in lines 1 and 2 above were in conformance with regulations and rules therefore as required in the current manual of survey instructions of the United States Department of the Interior, Bureau of Land Management or by a decree of a Court of Law and /or that the corner points mentioned in lines 3, 4 and 5 above were in conformance with the rules of the Michigan Board of Land Surveyors or by a Decree of a Court of Law; established, re-established, monumented, recovered, found as expressed below:

NOTE: Not more than 2 corners, all in the same town and range, may be recorded on this certificate.

A. Description of original monument and accessories and/or subsequent restoration:

GLO William Burt 1840 14" Tamarack S41W 66 lks
10" Spruce N14W 18 lks

No records of this corner being perpetuated, however various surveys indicate this corner's position Recorded in T42N, R2W, U.S.F.S. survey No. 4.
Found post of corner recovered by County Surveyor in 1940.

B. Description of corner evidence found and/or method applied in restoring or reestablishing corner:

1997 Found U.S.F.S. concrete post. Accepted location.

ACCEPTED BY THE MACKINAC COUNTY SURVEY PEER GROUP AS THE OFFICIAL CORNER UNDER P.A. 345 OF 1990 AT A MEETING HELD ON 11-21-97

C. Description of monument for corner and accessories established to perpetuate locating the position of the corner:

4"x4" concrete monument.

		(Face)	(Side Nail)
6" Cedar	N36W	7.6'	08.17'
6" Cedar (leaning)	S10E	10.2'	09.60'
9" Cedar	S38E	52.9'	52.97'
Sign Post	West	3.0'	
6" Cedar	S70W		07.74' (New)

STATE OF MICHIGAN
NEIL E. HILL
Land Surveyor
No. 27447
REGISTERED LAND SURVEYOR

Signed by Neil E. Hill P.S. Date DECEMBER 22, 1997

Surveyor's Michigan License No. 27447

FORM APPROVED BY MICHIGAN STATE BOARD OF PROFESSIONAL SURVEYORS, JAN. 28, 1971
REVISED MAY 14,1975
REVISED JAN., 1983
REVISED OCT., 1995

E-174