

**SURVEY &
REMONUMENTATION**

JAN 21 1999

SECTION

LAND CORNER RECORDATION CERTIFICATE
Filing Requirement of Act 74, Mich. P.A. 1970

Mackinac County Remonumentation Corner

For corners in

Mackinac County	Located in:	Corner Code #
1. Public Land Survey	T42N R01W	A-9
	T42N R02W	M-9 ✓
	T R	
	T R	
2. Property Controlling in Section	S T R	
	S T R	
3. Miscellaneous Property in Sec.	S T R	
	S T R	
4. Lot No.	Recorded Plat	
5. Private Claims		

RECEIVED & FILED
DIANE FRANKOVICH
MACKINAC COUNTY REGISTER OF DEEDS

DEC 31 1998

AM P/A
1|2|3|4|5|6|7|8|9|10|11|12|1|2|3|4|5|6

Register of Deeds Stamp & File Number

	A	B	C	D	E	F	G	H	I	J	K	L	M
1													
2	6		5		4		3		2				
3													
4	7		8		9		10		11		12		
5													
6	13		14		15		16		17		18		
7													
8	19		20		21		22		23		24		
9													
10	25		26		27		28		29		30		
11													
12	31		32		33		34		35		36		
13													

I, Neil E. Hill, in a field survey on 12-21-98, do hereby state that under requirements of P.A. 74, Michigan P.A. of 1970, the corner points mentioned in lines 1 and 2 above were in conformance with regulations and rules therefore as required in the current manual of survey instructions of the United States Department of the Interior, Bureau of Land Management or by a decree of a Court of Law and/or that the corner points mentioned in lines 3, 4 and 5 above were in conformance with the rules of the Michigan Board of Land Surveyors or by a Decree of a Court of Law, established, re-established, monumented, recovered, found as expressed below:

NOTE: Not more than 2 corners, all in the same town and range, may be recorded on this certificate.

A. Description of original monument and accessories and/or subsequent restoration:

1840 GLO Notes Austin Burt	8" Spruce	S 30 E	22 lks
	10" Spruce	N 24 W	33 lks
1965 Leonard Della-Moretta	5" Cedar	N 24 E	18.8'
Fd 1" pipe next to cedar post	7" Cedar	S 70 E	21.5'
and scribed 20" cedar	5" Balasm	S 12 W	36.1'
Liber 2, Page 306?	12" Cedar	N 35 W	24.6'
	4" Cedar Post	Due North	2.6'

ACCEPTED BY THE MACKINAC COUNTY SURVEY PEER GROUP AS THE OFFICIAL CORNER UNDER P.A. 345 OF 1990 AT A MEETING HELD ON 12-04-98 NEH


B. Description of corner evidence found and/or method applied in restoring or reestablishing corner:

1998 FFS pipe and cap next to a 4" sq monument and 4 witnesses
Accepted corner location

C. Description of monument for corner and accessories established to perpetuate locating the position of the corner:

Corner is a 1" pipe with FFS cap along side of a 4" sq conc mon

14" Cedar	N 24 E	18.80'
16" Cedar	N 73 E	21.50'
18" Cedar	N 35 W	42.62'
R/W Mkr	Due N	28.39'
4" Mkr Post	Due N	2.6'

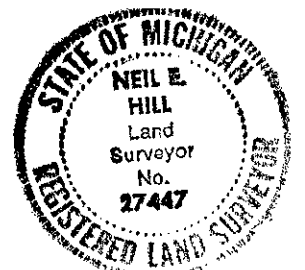

Bearings are compass bearings, corrected for declination, all distances are to a double-headed nail in the side of the witness object unless otherwise noted.

Signed by Neil E Hill P.S. Date 12-29-98

Surveyor's Michigan License No. 27447