


JAN 21 1999

T42N R03W

SECTION

St. Ignace Twp.

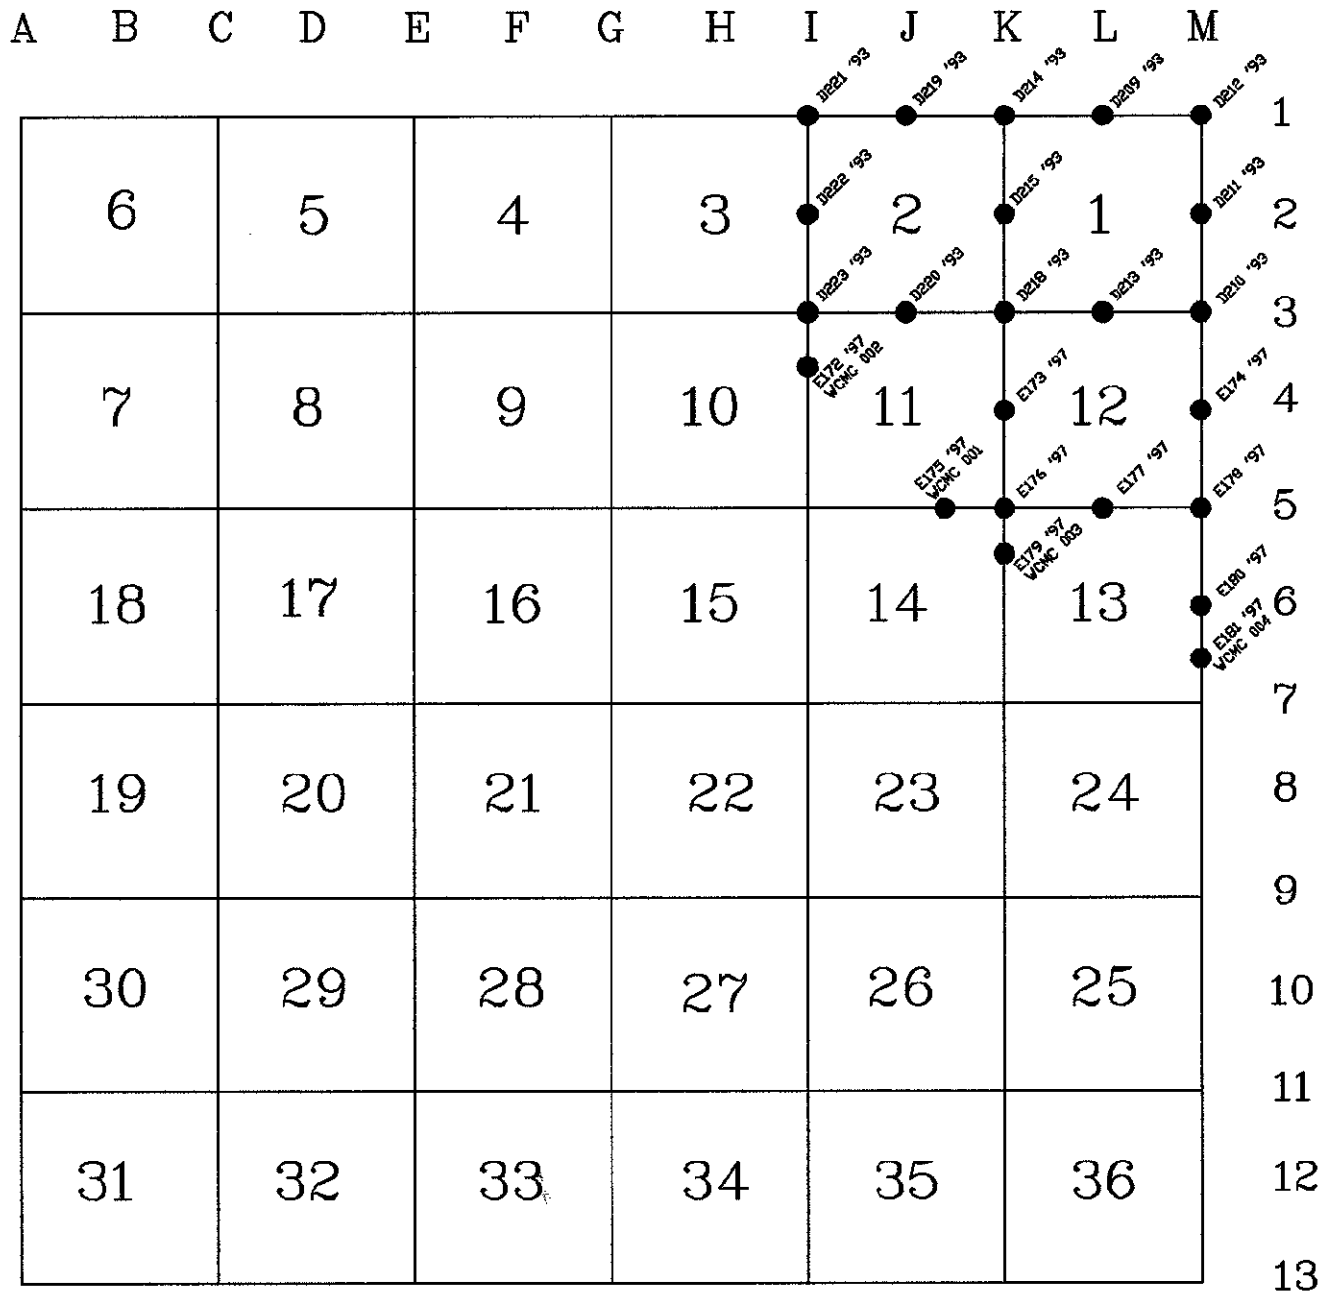

- Denotes Set ReMonumentation Corner in 1998
- Denotes Previously Set ReMonumentation Corner