LAND CORNER RECORDATION CERTIFICATE Filing Requirement of Act 74, Mich. P.A. 1970

MAR 2 0 2000

Mackinac County Remonumentation Corner

SECTION

For corners in

Comer Code # Mackinac County Located in: T42N R03W 1. Public Land Survey T R Т R Т R 2. Property Controlling S T R S Т R in Section R 3. Miscellaneous S T Property in Sec.

RECEIVED S FILED DIANE FRANKOVICH

FEB 25 2030

5/14 \$ 57 71819110111112111213141516

Register of Deeds Stamp & File Number

4. Lot No.


, Recorded Plat

1.1.1.64..0..44

5. Private Claims


I, Neil E. Hill, in a field survey on 12-20-99, do hereby state that under requirements of P.A. 74, Michigan P.A. of 1970, the corner points mentioned in lines 1 and 2 above were in conformance with regulations and rules therefore as required in the current manual of survey instructions of the United States Department of the Interior, Bureau of Land Management or by a decree of a Court of Law and /or that the corner points mentioned in lines 3, 4 and 5 above were in conformance with the rules of the Michigan Board of Land Surveyors or by a Decree of a Court of Law; established, re-established, monumented, recovered, found as expressed below:

NOTE: Not more than 2 corners, all in the same town and range, may be recorded on this certificate.

 

Oli On day for 1/ mark

1845	GLO Notes J H Mullett	8" Gedar for 1/4 post		
1968	Harold Stockholm	5" Cedar	S 60 E	64.7'
	Set 2" pipe	8" Cedar	S 48 W	82.3'
	by single proportion meas.	8" Spruce	N 81 W	69.5'
	Plat of Gov't land survey #7	Sign Post	Due W	2.0'

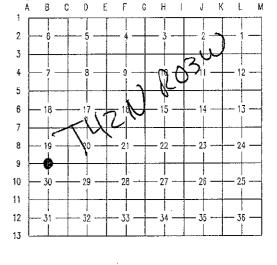

ACCEPTED BY THE MACKINAC COUNTY SURVEY PEER GROUP AS THE OFFICIAL CORNER UNDER PA. **345** OF 1990 AT A MEETING HELD ON 11-12-00

eil Entiel

No Subsequent Information


B. Description of corner evidence found and/or method applied in restoring or reestablishing corner:

1999 Fd 2" pipe and 2 witnesses Accepted corner location Placed 1/2 pipe with 4" Alum remonumentation cap

Corner is a 1/2" pipe with 4" Alum remonumentation cap Corner is on a power line and 45' South of CL of Red Camp Road

7" Cedar S 60 E 64.34 12" Cedar N 70 W 64.03 P Pole S 35 W 12.20' P Pole 20.54 S 65 W

Hand-held GPS position: 46-00-50 North 84-43-38 West

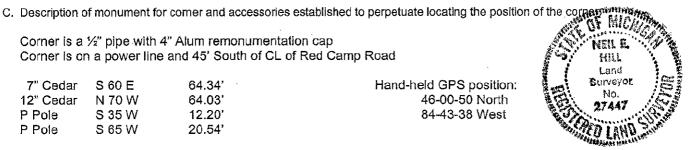

Bearings are compass bearings, corrected for declination, all distances are to a double- head nail in the side of the witness object unless otherwise noted.


Signed by

Date

January 21 2000

Surveyor's Michigan License No. 27447