

SURVEY &  
REMONUMENTATION

FEB 18 1994

COMMISSION

MACKINAC COUNTY REMONUMENTATION CORNER  
LAND CORNER RECORDATION CERTIFICATE  
Filing Requirement of Act 74, Mich. P.A. 1970

For corners in

Mackinac

(County)

Located In:

Corner Code ##

- |                                       |                          |            |
|---------------------------------------|--------------------------|------------|
| 1. Public Land Survey                 | T <u>42N</u> R <u>3W</u> | <u>I-2</u> |
|                                       | T _____ R _____          | _____      |
|                                       | T _____ R _____          | _____      |
|                                       | T _____ R _____          | _____      |
| 2. Property Controlling<br>in Section | S _____ T _____ R _____  | _____      |
|                                       | S _____ T _____ R _____  | _____      |
| 3. Miscellaneous<br>Property in Sec.  | S _____ T _____ R _____  | _____      |
|                                       | S _____ T _____ R _____  | _____      |

4. Lot No. \_\_\_\_\_, Recorded Plat \_\_\_\_\_  
5. Private Claims \_\_\_\_\_

RECEIVED & FILED  
DIANE PEAR KOVICH  
MACKINAC COUNTY REGISTER OF DEEDS

DEC 06 1993

AM \_\_\_\_\_ PM \_\_\_\_\_  
7/8/91 10/11/91 12/13/91 1/2/92

Register of Deeds Stamp & File Number

I, James H. Granger, in a field survey on November 10-24, 19 93, do hereby certify that under requirements of P.A. 74, Michigan P.A. of 1970, the corner points mentioned in lines 1 and 2 above were in conformance with regulations and rules therefore as required in the current manual of survey instructions of the United States Department of the Interior, Bureau of Land Management or by a decree of a Court of Law and/or that the corner points mentioned in lines 3, 4 and 5 above were in conformance with the rules of the Michigan Board of Land Surveyors or by a Decree of a Court of Law; established, re-established, monumented, re-monumented, recovered, found as expressed below:

**NOTE: Not more than 4 corners, all in the same town and range, may be recorded on this certificate.**

A. Description of original monument and accessories and/or subsequent restoration:

1845 Original Survey James H. Mullett  
Set Wood Post  
6" Tamarack N 21° W 10 lks  
10" Tamarack S 39° W 5 lks

1976 Jerry Wilcox #14102  
1991 USFS Bill Bowman #28406


B. Description of corner evidence found and/or method applied in restoring or reestablishing corner:

Fd 1" pipe  
No evidence of 1976/1991 witnesses

C. Description of monument for corner and accessories established to perpetuate locating the position of the corner:

Replaced 1" pipe with 5/8" x 30" rod with 3" dia. alum. cap  
1 1/2" pipe N 85° W 33.74'  
12" Cedar S 46° E 42.13' Fd nail  
Set nail & tag PS #16041 in:  
Power Pole N 23° W 111.53'  
Power Pole N 23° E 107.85'

	A	B	C	D	E	F	G	H	I	J	K	L	M
2	6	5	4	3	2	1							
3													
4	7	8	9	10	11	12							
5													
6	18	17	16	15	14	13							
7													
8	19	20	21	22	23	24							
9													
10	30	29	28	27	26	25							
11													
12	31	32	33	34	35	36							
13													

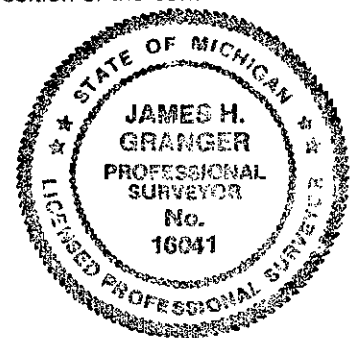

Signed by James H. Granger Date DEC. 3, 1993  
Surveyor's Michigan License No. 16041