SURVEY & REMONUMENTATION

FEB 18 1994

COMMISSION

MACKINAC COUNTY REMONUMENTATION CORNER

LAND CORNER RECORDATION CERTIFICATE

Filing Requirement of Act 74, Mich. P.A. 1970

For corners in Mackinac (County)

	Located In:	Corner Code 44
1. Public Land Survey	T 42N R 3W	I-3
	T ___ R ___	
	T ___ R ___	
	T ___ R ___	
2. Property Controlling	S ___ T ___ R ___	
in Section	S ___ T ___ R ___	
3. Miscellaneous	S ___ T ___ R ___	
Property in Sec.	S ___ T ___ R ___	

RECEIVED & FILED
DIANE HEAP KOVICH
MACKINAC COUNTY REGISTER OF DEEDS

DEC 06 1993

AM PM
7|8|9|10|11|12|1|2|3|4|5|6

Register of Deeds Stamp & File Number

4. Lot No. _____, Recorded Plat _____
5. Private Claims _____

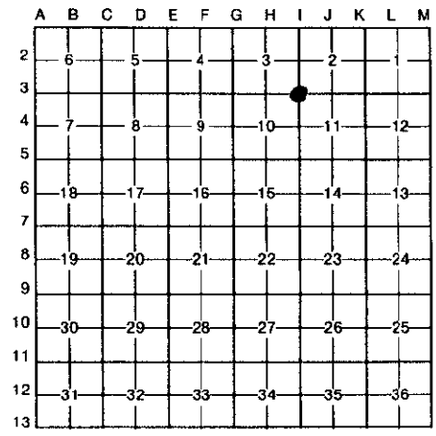

I, James H. Granger, in a field survey on November 10-24, 19 93, do hereby certify that under requirements of P.A. 74, Michigan P.A. of 1970, the corner points mentioned in lines 1 and 2 above were in conformance with regulations and rules therefore as required in the current manual of survey instructions of the United States Department of the Interior, Bureau of Land Management or by a decree of a Court of Law and/or that the corner points mentioned in lines 3, 4 and 5 above were in conformance with the rules of the Michigan Board of Land Surveyors or by a Decree of a Court of Law; established, re-established, monumented, re-monumented, recovered, found as expressed below:

NOTE: Not more than 4 corners, all in the same town and range, may be recorded on this certificate.

A. Description of original monument and accessories and/or subsequent restoration:

1845 Original Survey James H. Mullett
Set Wood Post
10" Spruce N 60° W 14 lks
10" Tamarack S 22° E 16 lks
1976 Jerry Wilcox #14102
1987 Neil Hill #27447
1991 USFS Bill Bowman # 28406

B. Description of corner evidence found and/or method applied in restoring or reestablishing corner:

Fd monument box - no iron inside
Found two 1987/1991 witnesses - distances place iron outside of mon. box. Road work performed in 1992.
Excavated at witnesses intersection - no evidence of corner

C. Description of monument for corner and accessories established to perpetuate locating the position of the corner:

5/8" x 30" rod with 3" dia. alum. cap in mon. box
Chis. "X" N. end Headwall S 3° E 36.75'
Chis. "X" N. end Headwall S 50° W 53.03'
Chis. "X" S. end Headwall N 23° W 85.10'
Chis. "X" S. end Headwall N 6° E 75.34'
Centerline M-134 North 20.0'

STATE OF MICHIGAN
JAMES H. GRANGER
PROFESSIONAL SURVEYOR
No. 16041
LICENSED PROFESSIONAL SURVEYOR

Signed by James H Granger Date Dec. 3, 1993

Surveyor's Michigan License No. 16041

FORM APPROVED BY MICHIGAN STATE BOARD OF LAND SURVEYORS, JAN. 28, 1971
REVISED MAY 14, 1975
REVISED JAN., 1983

D-223.