

SURVEY &
REMONUMENTATION

FEB 18 1994

COMMISSION

MACKINAC COUNTY REMONUMENTATION CORNER
LAND CORNER RECORDATION CERTIFICATE
Filing Requirement of Act 74, Mich. P.A. 1970

For corners in

Mackinac

(County)

Located In:

Corner Code ≠#

1. Public Land Survey	T	<u>42N</u>	R	<u>3W</u>	<u>J-3</u>	
	T	_____	R	_____	_____	
	T	_____	R	_____	_____	
	T	_____	R	_____	_____	
2. Property Controlling in Section	S	_____	T	_____	R	_____
	S	_____	T	_____	R	_____
3. Miscellaneous Property in Sec.	S	_____	T	_____	R	_____
	S	_____	T	_____	R	_____

RECEIVED & FILED
DIANE FRANKOVICH
MACKINAC COUNTY REGISTRE OF DEEDS

DEC 06 1993
AM _____ PM _____
7|8|9|10|11|12|1|2|3|4|5|6

Register of Deeds Stamp & File Number

4. Lot No. _____, Recorded Plat _____
5. Private Claims _____

A	B	C	D	E	F	G	H	I	J	K	L	M
2	6	5	4	3	2	1						
3									●			
4	7	8	9	10	11	12						
5												
6	18	17	16	15	14	13						
7												
8	19	20	21	22	23	24						
9												
10	30	29	28	27	26	25						
11												
12	31	32	33	34	35	36						
13												

I, James H. Granger, in a field survey on November 10-24, 19 93, do hereby certify that under requirements of P.A. 74, Michigan P.A. of 1970, the corner points mentioned in lines 1 and 2 above were in conformance with regulations and rules therefore as required in the current manual of survey instructions of the United States Department of the Interior, Bureau of Land Management or by a decree of a Court of Law and/or that the corner points mentioned in lines 3, 4 and 5 above were in conformance with the rules of the Michigan Board of Land Surveyors or by a Decree of a Court of Law; established, re-established, monumented, re-monumented, recovered, found as expressed below:


NOTE: Not more than 4 corners, all in the same town and range, may be recorded on this certificate.

A. Description of original monument and accessories and/or subsequent restoration:

- 1845 Original Survey James H. Mullett
 - Set Wood Post
 - 8" Birch N 31° W 11 lks
 - 6" Tamarack S 16° E 11 lks
- 1976 Jerry Wilcox #14102
- 1985 Larry Rogers #29251
- 1991 USFS Bill Bowman #28406

B. Description of corner evidence found and/or method applied in restoring or reestablishing corner:

- Fd 1/2" iron set by Larry Rogers #29251
- Found four 1985 witnesses

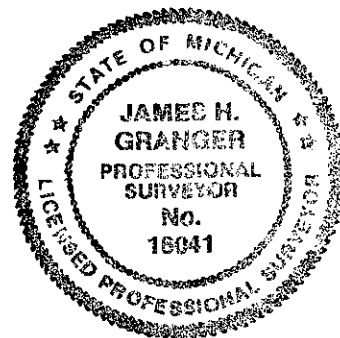

C. Description of monument for corner and accessories established to perpetuate locating the position of the corner:

- Replaced 1/2" iron with 5/8" x 30" rod with 3" dia. alum. cap
- 7" White Birch N 62° W 22.08' Fd nail
- 9" Twin Cedar N 6° W 35.22' Fd nail
- 11" Cedar S 4° E 17.56' Fd nail
- 1/2" Iron pin N 2° E 31.83'
- 16" Poplar S 83° E 39.29' Nail & tag PS# 16041

Signed by James H. Granger Date DEC. 3, 1993
Surveyor's Michigan License No. 16041