

SURVEYOR'S
LICENSED PROFESSIONAL SURVEYOR

FEB 18 1994

COMMISSION

MACKINAC COUNTY REMONUMENTATION CORNER
LAND CORNER RECORDATION CERTIFICATE
Filing Requirement of Act 74, Mich. P.A. 1970

For corners in

Mackinac Located In: _____ Corner Code # _____
(County)

1. Public Land Survey T 42N R 3W _____ L-3
T _____ R _____
T _____ R _____
T _____ R _____

2. Property Controlling S _____ T _____ R _____
in Section S _____ T _____ R _____

3. Miscellaneous S _____ T _____ R _____
Property in Sec. S _____ T _____ R _____

4. Lot No. _____, Recorded Plat _____

5. Private Claims _____

RECEIVED & FILED
DIANE FRANKOVICH
MACKINAC COUNTY REGISTER OF DEEDS

DEC 06 1993
AM _____ PM _____
7|8|9|10|11|12|13|14|15|16

Register of Deeds Stamp & File Number


I, James H. Granger, in a field survey on November 10-24, 19 93, do hereby certify that under requirements of P.A. 74, Michigan P.A. of 1970, the corner points mentioned in lines 1 and 2 above were in conformance with regulations and rules therefore as required in the current manual of survey instructions of the United States Department of the Interior, Bureau of Land Management or by a decree of a Court of Law and/or that the corner points mentioned in lines 3, 4 and 5 above were in conformance with the rules of the Michigan Board of Land Surveyors or by a Decree of a Court of Law; established, re-established, monumented, re-monumented, recovered, found as expressed below:

	A	B	C	D	E	F	G	H	I	J	K	L	M
2	6		5		4		3		2		1		
3													
4	7		8		9		10		11		12		
5													
6	18		17		16		15		14		13		
7													
8	19		20		21		22		23		24		
9													
10	30		29		28		27		26		25		
11													
12	31		32		33		34		35		36		
13													

NOTE: Not more than 4 corners, all in the same town and range, may be recorded on this certificate.

A. Description of original monument and accessories and/or subsequent restoration:
1845 Original Survey James H. Mullett
Corner was 10" Sugar Maple
1941 Co. Surveyor Fremont Skeels
1979 Tom Kelly #24599
1990 USFS Bill Bowman #28406

B. Description of corner evidence found and/or method applied in restoring or reestablishing corner:
Fd 1941 monument
Found one 1978 witness
Found two 1990 witnesses
Found one unidentified witness

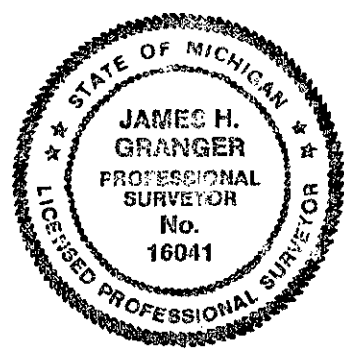

C. Description of monument for corner and accessories established to perpetuate locating the position of the corner:
Replaced 1941 monument with 5/8" x 30" rod with 3" dia. alumin. cap
8" Twin Maple N 11° E (N 14° E R) 14.10' (13.90' R) 1978
12" Maple S 54° E 8.88' (8.9' R) 1990
Post N 2° E (NORTH R) 2.98' (8.0' R) 1990
4" Poplar S 75° W 14.77' unidentified witness nail
4" Spruce N 72° W 9.78' nail & tag PS #16041

Signed by James H. Granger Date Dec. 3, 1993
Surveyor's Michigan License No. 16041

D-213