

**SURVEY &
REMONUMENTATION**

FEB 18 1994

COMMISSION

**MACKINAC COUNTY REMONUMENTATION CORNER
LAND CORNER RECORDATION CERTIFICATE
Filing Requirement of Act 74, Mich. P.A. 1970**

For corners in
Mackinac

(County)

Located In:

Corner Code ≠#

1. Public Land Survey	T <u>42N</u> R <u>3W</u>	<u>M-1</u>
	T _____ R _____	_____
	T _____ R _____	_____
	T _____ R _____	_____
2. Property Controlling in Section	S _____ T _____ R _____	_____
	S _____ T _____ R _____	_____
3. Miscellaneous Property in Sec.	S _____ T _____ R _____	_____
	S _____ T _____ R _____	_____

RECEIVED & FILED
DIANE FRANKOVICH
MACKINAC COUNTY REGISTER OF DEEDS

DEC 06 1993
AM _____ PM _____

Register of Deeds Stamp & File Number

4. Lot No. _____, Recorded Plat _____
5. Private Claims _____

I, James H. Granger, in a field survey on November 10-24, 19 93, do hereby certify that under requirements of P.A. 74, Michigan P.A. of 1970, the corner points mentioned in lines 1 and 2 above were in conformance with regulations and rules therefore as required in the current manual of survey instructions of the United States Department of the Interior, Bureau of Land Management or by a decree of a Court of Law and/or that the corner points mentioned in lines 3, 4 and 5 above were in conformance with the rules of the Michigan Board of Land Surveyors or by a Decree of a Court of Law; established, re-established, monumented, re-monumented, recovered, found as expressed below:


NOTE: Not more than 4 corners, all in the same town and range, may be recorded on this certificate.

	A	B	C	D	E	F	G	H	I	J	K	L	M
2	6	5	4	3	2								
3													
4	7	8	9	10	11	12							
5													
6	18	17	16	15	14	13							
7													
8	19	20	21	22	23	24							
9													
10	30	29	28	27	26	25							
11													
12	31	32	33	34	35	36							
13													

A. Description of original monument and accessories and/or subsequent restoration:
 1840 Original Survey Austin Burt
 Set Wood Post
 12" Fir N 8° W 7 lks
 6" Fir S 50° E 5 lks
 1976 USFS Charles Bobo
 1985 USFS Michael Lange #30089
 1990 USFS Bill Bowman #28406

B. Description of corner evidence found and/or method applied in restoring or reestablishing corner:
 1976 Monument Destroyed
 Fd 1/2" iron with cap #31591 in box 1.5'-2' below road surface
 Found four 1990 USFS witnesses which check with 1/2" iron

C. Description of monument for corner and accessories established to perpetuate locating the position of the corner:
 5/8" x 30" rod with 3" dia. alumin. cap inside mon. box
 6" below road surface
 11" S. Pine N 52° E 69.86' fd nail
 12" W. Spruce S 64° E 44.80' set nail & tag PS #16041
 Utility Pole N 16° W 112.40' fd nail
 Post East 29.48' fd nail

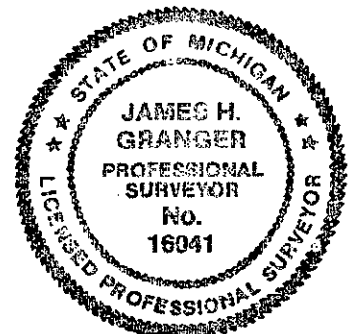

Signed by James H. Granger
 Surveyor's Michigan License No. 16041

Date Dec. 3, 1993

D-212