

FEB 18 1994

COMMISSION

MACKINAC COUNTY REMONUMENTATION CORNER  
LAND CORNER RECORDATION CERTIFICATE  
Filing Requirement of Act 74, Mich. P.A. 1970

For corners in  
Mackinac

(County)

Located In:

Corner Code #

- 1. Public Land Survey T 42N R 3W M-2  
T \_\_\_\_\_ R \_\_\_\_\_  
T \_\_\_\_\_ R \_\_\_\_\_  
T \_\_\_\_\_ R \_\_\_\_\_
- 2. Property Controlling S \_\_\_\_\_ T \_\_\_\_\_ R \_\_\_\_\_  
in Section S \_\_\_\_\_ T \_\_\_\_\_ R \_\_\_\_\_
- 3. Miscellaneous S \_\_\_\_\_ T \_\_\_\_\_ R \_\_\_\_\_  
Property in Sec. S \_\_\_\_\_ T \_\_\_\_\_ R \_\_\_\_\_
- 4. Lot No. \_\_\_\_\_, Recorded Plat \_\_\_\_\_
- 5. Private Claims \_\_\_\_\_

RECEIVED & FILED  
DIANE FRANKOVICH  
MACKINAC COUNTY REGISTER OF DEEDS

DEC 06 1993

AM \_\_\_\_\_ PM  
7|8|9|10|11|12|1|2|3|4|5|6

Register of Deeds Stamp & File Number

I, James H. Granger, in a field survey on November 10-24, 1993, do hereby certify that under requirements of P.A. 74, Michigan P.A. of 1970, the corner points mentioned in lines 1 and 2 above were in conformance with regulations and rules therefore as required in the current manual of survey instructions of the United States Department of the Interior, Bureau of Land Management or by a decree of a Court of Law and/or that the corner points mentioned in lines 3, 4 and 5 above were in conformance with the rules of the Michigan Board of Land Surveyors or by a Decree of a Court of Law; established, re-established, monumented, re-monumented, recovered, found as expressed below:

**NOTE: Not more than 4 corners, all in the same town and range, may be recorded on this certificate.**

	A	B	C	D	E	F	G	H	I	J	K	L	M
2	6	5	4	3	2	1							
3													
4	7	8	9	10	11	12							
5													
6	18	17	16	15	14	13							
7													
8	19	20	21	22	23	24							
9													
10	30	29	28	27	26	25							
11													
12	31	32	33	34	35	36							
13													

A. Description of original monument and accessories and/or subsequent restoration:

1840 Original Survey Austin Burt  
Set Wood Post  
11" Hemlock S 53° W 19 lks  
8" Birch N 22° W 13 lks.

1976 USFS Charles Bobo  
1981 USFS Harold Stockholm #23519  
1991 USFS Bill Bowman #28406


B. Description of corner evidence found and/or method applied in restoring or reestablishing corner:

Fd iron with 3" dia. brass cap in a box 18" below road surface

No evidence of 1981/1991 witnesses  
Fd two witnesses with tag #31591

C. Description of monument for corner and accessories established to perpetuate locating the position of the corner:

Iron Pipe with brass cap  
4x4 Post N 84° W 19.85' nail & tag #31591  
4" Poplar S 61° E 51.50' nail & tag #31591  
Set nail and tag PS #16041 in:  
Power Pole N 16° W 59.56'  
Post N 37° E 74.70'  
4" Poplar N 60° E 62.26'  
12" Spruce S 28° W 84.33'

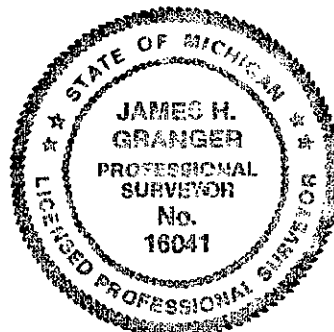

Signed by James H. Granger  
Surveyor's Michigan License No. 16041

Date DEC. 3, 1993

D-211