

STATE OF MICHIGAN
DEPARTMENT OF LAND SURVEYING

FEB 18 1994

COMMISSION

MACKINAC COUNTY REMONUMENTATION CORNER
LAND CORNER RECORDATION CERTIFICATE
Filing Requirement of Act 74, Mich. P.A. 1970

For corners in
Mackinac

(County)

Located In:

Corner Code #

- 1. Public Land Survey T 42N R 3W M-3
 T _____ R _____
 T _____ R _____
 T _____ R _____
- 2. Property Controlling S _____ T _____ R _____
 in Section S _____ T _____ R _____
- 3. Miscellaneous S _____ T _____ R _____
 Property in Sec. S _____ T _____ R _____
- 4. Lot No. _____, Recorded Plat _____
- 5. Private Claims _____

RECEIVED & FILED
DIANE FRANKOVICH
MACKINAC COUNTY REGISTER OF DEEDS

DEC 06 1993
AM _____ PM
7|8|9|10|11|12|13|14|15|16

Register of Deeds Stamp & File Number

I, James H. Granger, in a field survey on November 10-24, 19 93, do hereby certify that under requirements of P.A. 74, Michigan P.A. of 1970, the corner points mentioned in lines 1 and 2 above were in conformance with regulations and rules therefore as required in the current manual of survey instructions of the United States Department of the Interior, Bureau of Land Management or by a decree of a Court of Law and/or that the corner points mentioned in lines 3, 4 and 5 above were in conformance with the rules of the Michigan Board of Land Surveyors or by a Decree of a Court of Law; established, re-established, monumented, re-monumented, recovered, found as expressed below:

	A	B	C	D	E	F	G	H	I	J	K	L	M
2	6		5		4		3		2		1		
3													
4	7		8		9		10		11		12		
5													
6	18		17		16		15		14		13		
7													
8	19		20		21		22		23		24		
9													
10	30		29		28		27		26		25		
11													
12	31		32		33		34		35		36		
13													

NOTE: Not more than 4 corners, all in the same town and range, may be recorded on this certificate.

A. Description of original monument and accessories and/or subsequent restoration:


- 1840 Original Survey Austin Burt
- Set Wood Post
- 12" Aspen S 74° W 19 lks
- 12" Birch N 67° W 8 lks
- 1940 Co. Surveyor Fremont Skeels #1357
- 1976 USFS Charles Bobo
- 1979 Tom Kelly #24599
- 1991 USFS Bill Bowman #28406

B. Description of corner evidence found and/or method applied in restoring or reestablishing corner:

- Fd 1940 monument
- Found four 1976/1991 witnesses

C. Description of monument for corner and accessories established to perpetuate locating the position of the corner:

- Replaced 1940 monument with 5/8" x 30" rod with 3" dia. alumin. cap
- Set nail & tag PS #16041 in:
- 8" Cedar S 32° E 23.50'
- 6" Spruce S 27° W 15.82'
- 10" Spruce N 65° E 129.92'
- Utility Pole N 84° W 53.37'

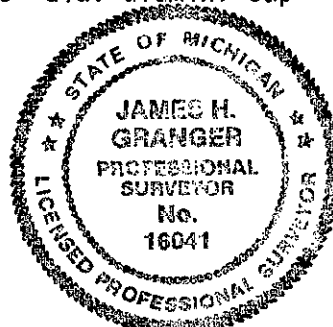

Signed by James H. Granger

Date Dec. 3, 1993

Surveyor's Michigan License No. 16041

b-210