


T42N R04W

A B C D E F G H I J K L M

Brevort Twp.

St. Ignace Twp.

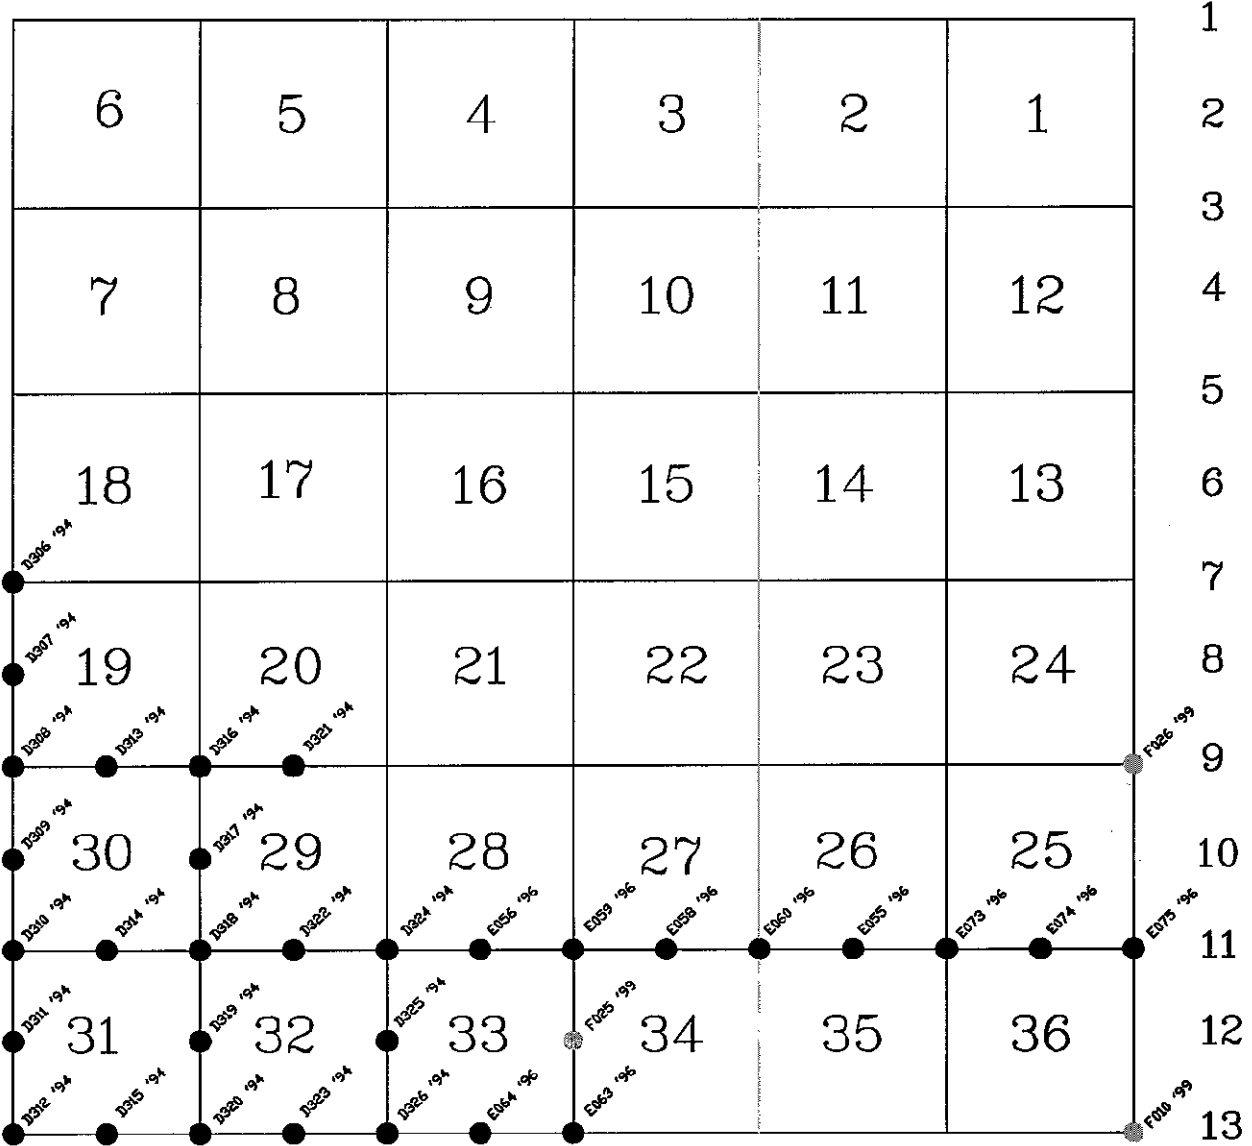

● Denotes Set ReMonumentation Corner in 1999
 ● Denotes Previously Set ReMonumentation Corner

MAR 01 2000
 SECTION