

LAND CORNER RECORDATION CERTIFICATE
Filing Requirement of Act 74, Mich. P.A. 1970

For corners in
Mackinac
(County)

SURVEY &
REMONUMENTATION
APR 10 1995
COMMISSION

Located In:

Corner Code =#

- 1. Public Land Survey T 42N R 4W A-10
- T R
- T R
- T R
- 2. Property Controlling S T R
- in Section S T R
- 3. Miscellaneous S T R
- Property in Sec. S T R

RECEIVED & FILED
DIANE DEAN KUYON
MACKINAC COUNTY REGISTER OF DEEDS

NOV 09 1994
AM PM
7:31:16 11:14:12 13:15:16

Register of Deeds Stamp & File Number

- 4. Lot No. _____, Recorded Plat _____
- 5. Private Claims _____

I, David B. Guthrie in a field survey on July 15, 19 94, do hereby certify that under requirements of P.A. 74, Michigan P.A. of 1970, the corner points mentioned in lines 1 and 2 above were in conformance with regulations and rules therefore as required in the current manual of survey instructions of the United States Department of the Interior, Bureau of Land Management or by a decree of a Court of Law and/or that the corner points mentioned in lines 3, 4 and 5 above were in conformance with the rules of the Michigan Board of Land Surveyors or by a Decree of a Court of Law; established, re-established, monumented, re-monumented, recovered, found as expressed below:

NOTE: Not more than 4 corners, all in the same town and range, may be recorded on this certificate.

A. Description of original monument and accessories and/or subsequent restoration:

- 1840: Established by Wm. Burt, G.L.O. Survey. Set wood post and referenced:
Aspen 6/S40W/11
Aspen 8/N40W/4
- 1975: Survey by Glenn A. Bergey, Set 40 Penny Spike. Set on line and at Proportionate distance between controlling corners.
- 1977: Survey by Larry Feindt. Found 40 Penny Spike.

B. Description of corner evidence found and/or method applied in restoring or reestablishing corner:

- 1994: Set 1/2" Iron Rod 33 feet east of 3" aluminum capped reference monument.

C. Description of monument for corner and accessories established to perpetuate locating the position of the corner:

- 1994: Set Mackinac County Remonumentation Corner.
A 5/8" by 24" Iron Rod with a 3" aluminum cap stamped to identify the corner set within a monument box.


Referenced:

- West - 33.00 feet - 3" aluminum capped ref. mon. (exist.)
- N24°W - 101.50 feet - 8" Cedar (Exist.)
- S38°W - 61.89 feet - Utility Pole (Exist.)
- S72°E - 36.66 feet - 3" Cedar

Signed by D.B. Guthrie
Surveyor's Michigan License No. 22435

Date Oct. 21, 1994

ACCEPTED BY THE MACKINAC COUNTY
SURVEY PEER GROUP AS THE
OFFICIAL CORNER UNDER P.A.
345 OF 1990 AT A MEETING
HELD ON 8-16-94
James H. Shanger

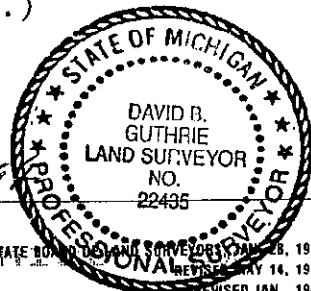

| | A | B | C | D | E | F | G | H | I | J | K | L | M |
|----|----|---|----|---|----|---|----|---|----|---|----|---|---|
| 2 | 6 | | 5 | | 4 | | 3 | | 2 | | 1 | | |
| 3 | | | | | | | | | | | | | |
| 4 | 7 | | 8 | | 9 | | 10 | | 11 | | 12 | | |
| 5 | | | | | | | | | | | | | |
| 6 | 18 | | 17 | | 16 | | 15 | | 14 | | 13 | | |
| 7 | | | | | | | | | | | | | |
| 8 | 19 | | 20 | | 21 | | 22 | | 23 | | 24 | | |
| 9 | | | | | | | | | | | | | |
| 10 | 30 | | 29 | | 28 | | 27 | | 26 | | 25 | | |
| 11 | | | | | | | | | | | | | |
| 12 | 31 | | 32 | | 33 | | 34 | | 35 | | 36 | | |
| 13 | | | | | | | | | | | | | |

11-09-94

MSBR