

LAND CORNER RECORDATION CERTIFICATE
Filing Requirement of Act 74, Mich. P.A. 1970

For corners in
Mackinac

SURVEY &
REMONUMENTATION
APR 10 1995
COMMISSION

- Located In: _____ Corner Code # _____
- | | | | | | |
|------------------------------------|---|-------|---|-------|-------|
| 1. Public Land Survey | T | 42N | R | 4W | A-11 |
| | T | _____ | R | _____ | _____ |
| | T | _____ | R | _____ | _____ |
| | T | _____ | R | _____ | _____ |
| 2. Property Controlling in Section | S | _____ | T | _____ | R |
| | S | _____ | T | _____ | R |
| 3. Miscellaneous Property in Sec. | S | _____ | T | _____ | R |
| | S | _____ | T | _____ | R |
4. Lot No. _____, Recorded Plat _____
5. Private Claims _____

RECEIVED & FILED
DIANE FRAT KAWICH
MACKINAC COUNTY REGISTER OF DEEDS

NOV 09 1994
AM PM
7|8|9|10|11|12|1|2|3|4|5|6

Register of Deeds Stamp & File Number

	A	B	C	D	E	F	G	H	I	J	K	L	M
2	6	5	4	3	2	1							
3													
4	7	8	9	10	11	12							
5													
6	18	17	16	15	14	13							
7													
8	19	20	21	22	23	24							
9													
10	30	29	28	27	26	25							
11													
12	31	32	33	34	35	36							
13													

I, David B. Guthrie in a field survey on June 15, 1994, do hereby certify that under requirements of P.A. 74, Michigan P.A. of 1970, the corner points mentioned in lines 1 and 2 above were in conformance with regulations and rules therefore as required in the current manual of survey instructions of the United States Department of the Interior, Bureau of Land Management or by a decree of a Court of Law and/or that the corner points mentioned in lines 3, 4 and 5 above were in conformance with the rules of the Michigan Board of Land Surveyors or by a Decree of a Court of Law; established, re-established, monumented, re-monumented, recovered, found as expressed below:

NOTE: Not more than 4 corners, all in the same town and range, may be recorded on this certificate.

- A. Description of original monument and accessories and/or subsequent restoration:
- 1840: Established by Wm. Burt, G.L.O. Survey. Set post and referenced:
Pine 12/S19W/31
Cedar 10/N76W/18
 - 1975: Survey By Glenn A. Bergey. Set 2"x2' Iron Pipe with Brass Cap.
 - 1977: Survey by Larry Feindt. Found P.K. Nail above 2"x2' Iron Pipe.
 - 1982: Survey by Thomas M. Kelly. Found U.S.F.S. Brass capped Monument buried 18" below the surface. Set 1/2" Iron Rod above the Corner.


- B. Description of corner evidence found and/or method applied in restoring or reestablishing corner:
- 1994: Found 1/2" Iron Rod 1.5' West of the Centerline of Black Point Road.

ACCEPTED BY THE MACKINAC COUNTY SURVEY PEER GROUP AS THE OFFICIAL CORNER UNDER P.A. 345 OF 1990 AT A MEETING HELDON 8-16-99

James H. Kranger

- C. Description of monument for corner and accessories established to perpetuate locating the position of the corner:
- 1994: Set Mackinac County Remonumentation Corner. A 5/8" by 24" Iron Rod with a 3" aluminum cap stamped to identify the corner set within a monument box.

- Referenced;
- S61°W - 42.75 feet - Utility Pole
 - S28°E - 75.23 feet - 6" Ash
 - S30°E - 58.20 feet - 16" Elm Stump (Exist.)
 - N18°E - 167.20 feet - 8" Ash (Exist.)
 - N36°W - 77.00 feet - 5" Cedar

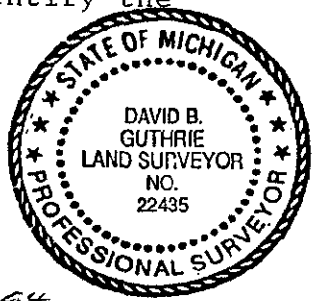

Signed by David B. Guthrie Date Oct. 21, 1994
Surveyor's Michigan License No. 22435