

1994 Mackinac County Remonumentation Corner.

**LAND CORNER RECORDATION CERTIFICATE**  
**Filing Requirement of Act 74, Mich. P.A. 1970**

For corners in

**Mackinac** (County) Located In: Corner Code **#**

1. Public Land Survey T 4N R 4W A-12

2. Property Controlling in Section S T R

3. Miscellaneous Property in Sec. S T R

RECEIVED & FILED  
 DIANE GRABER FOR COM  
 MACKINAC COUNTY REGISTER OF DEEDS

NOV 09 1994  
 AM PM  
 7/8/9/10/11/12/13/14/15/16

Register of Deeds Stamp & File Number

4. Lot No. \_\_\_\_\_, Recorded Plat \_\_\_\_\_

5. Private Claims \_\_\_\_\_

	A	B	C	D	E	F	G	H	I	J	K	L	M
2	6	5	4	3	2	1							
3													
4	7	8	9	10	11	12							
5													
6	18	17	16	15	14	13							
7													
8	19	20	21	22	23	24							
9													
10	30	29	28	27	26	25							
11													
12	31	32	33	34	35	36							
13													

I, David B. Guthrie in a field survey on June 15, 1994, do hereby certify that under requirements of P.A. 74, Michigan P.A. of 1970, the corner points mentioned in lines 1 and 2 above were in conformance with regulations and rules therefore as required in the current manual of survey instructions of the United States Department of the Interior, Bureau of Land Management or by a decree of a Court of Law and/or that the corner points mentioned in lines 3, 4 and 5 above were in conformance with the rules of the Michigan Board of Land Surveyors or by a Decree of a Court of Law; established, re-established, monumented, re-monumented, recovered, found as expressed below:

**NOTE: Not more than 4 corners, all in the same town and range, may be recorded on this certificate.**

**A. Description of original monument and accessories and/or subsequent restoration:**

- 1840: Established by Wm. Burt, G.L.O. Survey. Set post and referenced:  
 Beech /N23W/47  
 Beech /S88W/21
- 1977: Survey by Larry Feindt. Found Iron Spike
- 1982: Survey by Thomas M. Kelly. Found 1/2" Iron Rod

**B. Description of corner evidence found and/or method applied in restoring or reestablishing corner:**

- 1994: Set 1/2" Iron Rod in existing Monument Box, the 1/2" Iron Rod was reset from previous references.


ACCEPTED BY THE MACKINAC COUNTY SURVEY PEER GROUP AS THE OFFICIAL CORNER UNDER P.A. 345 OF 1990 AT A MEETING HELDON 8-16-94

*Jane H. [Signature]*

**C. Description of monument for corner and accessories established to perpetuate locating the position of the corner:**

- 1994: Set Mackinac County Remonumentation Corner. A 5/8" by 24" Iron Rod with a 3" aluminum cap stamped to identify the corner set within a monument box.

- Referenced;
- S45°E - 65.10 feet - 6" Apple (Exist.)
  - S65°W - 62.67 feet - Cable Marker (Exist.)
  - N50°W - 46.90 feet - Utility Pole (exist.)
  - S34°W - 84.40 feet - 7" Spruce

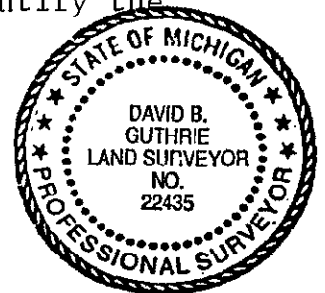

Signed by David B. Guthrie Date Oct. 21, 1994

Surveyor's Michigan License No. 22435