

1994 Mackinac County Remonumentation Corner.

SURVEY & REMONUMENTATION COMMISSION
APR 10 1995

LAND CORNER RECORDATION CERTIFICATE
Filing Requirement of Act 74, Mich. P.A. 1970

For corners in

Mackinac
(County)

Located In:

Corner Code ##

- 1. Public Land Survey T 42N R 4W B-9
- T _____ R _____
- T _____ R _____
- T _____ R _____
- 2. Property Controlling S _____ T _____ R _____
- in Section S _____ T _____ R _____
- 3. Miscellaneous S _____ T _____ R _____
- Property in Sec. S _____ T _____ R _____

RECEIVED & FILED
DIANE CRAIG KOVICH
REGISTER OF DEEDS

NOV 09 1994
AM PM

Register of Deeds Stamp & File Number

- 4. Lot No. _____, Recorded Plat _____
- 5. Private Claims _____

	A	B	C	D	E	F	G	H	I	J	K	L	M
2	6	5	4	3	2	1							
3													
4	7	8	9	10	11	12							
5													
6	18	17	16	15	14	13							
7													
8	19	20	21	22	23	24							
9	●												
10	30	29	28	27	26	25							
11													
12	31	32	33	34	35	36							
13													

I, David B. Guthrie in a field survey on October 19, 19 94, do hereby certify that under requirements of P.A. 74, Michigan P.A. of 1970, the corner points mentioned in lines 1 and 2 above were in conformance with regulations and rules therefore as required in the current manual of survey instructions of the United States Department of the Interior, Bureau of Land Management or by a decree of a Court of Law and/or that the corner points mentioned in lines 3, 4 and 5 above were in conformance with the rules of the Michigan Board of Land Surveyors or by a Decree of a Court of Law; established, re-established, monumented, re-monumented, recovered, found as expressed below:

NOTE: Not more than 4 corners, all in the same town and range, may be recorded on this certificate.

A. Description of original monument and accessories and/or subsequent restoration:

1845: Established by James A. Mullett. Set post and referenced:
Birch 3/S50E/08
Tamarack 10/N45W/13

B. Description of corner evidence found and/or method applied in restoring or reestablishing corner:

1994: Set Mackinac County Remonumentation Corner at single proportion between the Northwest and Northeast Corners of Section 30.


ACCEPTED BY THE MACKINAC COUNTY SURVEY PEER GROUP AS THE OFFICIAL CORNER UNDER P.A. 345 OF 1990 AT A MEETING HELDON 8-16-99

James H. [Signature]

C. Description of monument for corner and accessories established to perpetuate locating the position of the corner:

1994: Set Mackinac County Remonumentation Corner. Note - The actual corner location falls in a flooded area. A reference corner was set 232.16 feet east of the subject corner as measured along the section line. A 5/8" by 24" Iron Rod with a 3" aluminum cap stamped to identify the reference corner was placed.

Referenced: N42°E - 4" Spruce - 69.05 feet
N51° E - 7" Spruce - 64.49 feet
N65°E - 8" Spruce - 67.77 feet
N89°E - 5" Spruce - 72.30 feet

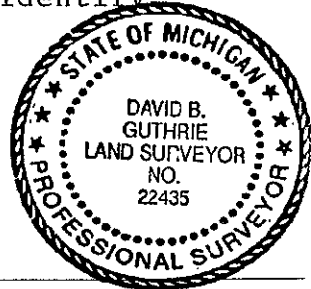

Signed by David B. Guthrie

Date Oct. 21, 1994

Surveyor's Michigan License No. 22435