1994 Mackinac County Remonumentation Corner.

SURVEY & REMONUMENTATION
APR 1 0 1995
COMMISSION

LAND CORNER RECORDATION CERTIFICATE

Filing Requirement of Act 74, Mich. P.A. 1970

For corners in Mackinac (County) Located In:

Corner Code ##

RECEIVED & FILED
DIANE FRAY BOUCHER
MACKINAC COUNTY REGISTER OF DEEDS
NOV 09 1994
AM PM
7|8|9|10|11|12|1|2|3|4|5|6

Register of Deeds Stamp & File Number

1. Public Land Survey T 42N R 4W C-9
   T ___ R ___
   T ___ R ___
   T ___ R ___
2. Property Controlling S ___ T ___ R ___
   in Section S ___ T ___ R ___
3. Miscellaneous S ___ T ___ R ___
   Property in Sec. S ___ T ___ R ___
4. Lot No. ___, Recorded Plat ___
5. Private Claims ___

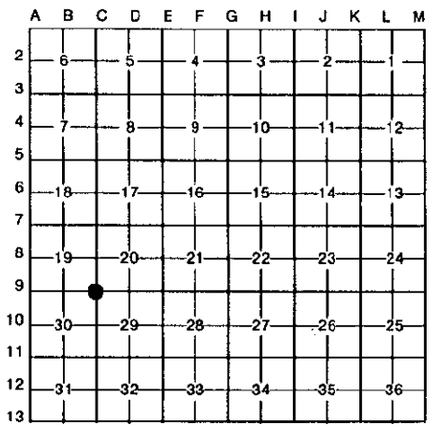

I, David B. Guthrie in a field survey on July 21, 19 94, do hereby certify that under requirements of P.A. 74, Michigan P.A. of 1970, the corner points mentioned in lines 1 and 2 above were in conformance with regulations and rules therefore as required in the current manual of survey instructions of the United States Department of the Interior, Bureau of Land Management or by a decree of a Court of Law and/or that the corner points mentioned in lines 3, 4 and 5 above were in conformance with the rules of the Michigan Board of Land Surveyors or by a Decree of a Court of Law; established, re-established, monumented, re-monumented, recovered, found as expressed below:

NOTE: Not more than 4 corners, all in the same town and range, may be recorded on this certificate.

A. Description of original monument and accessories and/or subsequent restoration:

1845: Established by James A. Mullett, G.L.O. Survey. Set post and referenced:
Aspen 4/N33W/23 Aspen 4/S30E/17
±1960: Survey by MDSH. Found 4" Square wooden Post.
1977: Survey by Wm. P. Richards. Found 4" Cedar Post, set 5/8" Iron Rod.

B. Description of corner evidence found and/or method applied in restoring or reestablishing corner:

1994: Found 1½" Iron Bar. Property owner stated that this 1½" Iron Bar was set to replace the former Cedar post at the same location when the road was built to the North.

ACCEPTED BY THE MACKINAC COUNTY SURVEY PEER GROUP AS THE OFFICIAL CORNER UNDER P.A. 345 OF 1990 AT A MEETING HELD ON 8-16-94
James H Granger

11-09-94 10:44 AM

C. Description of monument for corner and accessories established to perpetuate locating the position of the corner:

1994: Set Mackinac County Remonumentation Corner.
A 5/8" by 24" Iron Rod with a 3" aluminum cap stamped to identify, set 6" below the road gravel surface.

Referenced:
N55°W - 30.40 feet - 15" Cedar
N85°W - 53.55 feet - 18" Cedar
S74°E - 25.50 feet - NW Cor. Cabin
S15°E - 73.85 feet - Power Pole

STATE OF MICHIGAN
DAVID B. GUTHRIE
LAND SURVEYOR
NO. 22435
PROFESSIONAL SURVEYOR

Signed by David B. Guthrie Date Oct. 21, 1994

Surveyor's Michigan License No. 22435

11-09-94 FORM APPROVED BY MICHIGAN STATE BOARD OF LAND SURVEYORS, JAN. 28, 1971
REVISED MAY 14, 1971
REVISED JAN., 1983

D-0316