

4 Macking E County Remonumentation Corner.

LAND CORNER RECORDATION CERTIFICATE Filing Requirement of Act 74, Mich. P.A. 1970

FO	comers in 174 1.	~eiO	16		
_Ma	ckinac (County COMA)	1122	Located In:	Corner Code ##	
1.	Public Land Survey		T <u>42N</u> R <u>4W</u> T R	C-10	MACHINACONTO SOLO MOST
			T R T R		NOV 0 9 1994
2.	Property Controlling	s	T R		$AM = e_{N_1}$
3.	Miscellaneous	s	T R		Register of Deeds Stamp & File Number
	Property in Sec.	s	T R		Treglocal of Decay Statisty & File Halliber
4.	Lot No,	Recorded	i Plat		A B C D E F G H I J K L
5	Private Claims				

I, David B. Guthrie in a field survey on July 21 do hereby certify that under requirements of P.A. 74, Michigan P.A. of 1970, the corner points mentioned in lines 1 and 2 above were in conformance with regulations and rules therefore as required in the current manual of survey instructions of the United States Department of the Interior, Bureau of Land Management or by a decree of a Court of Law and/or that the corner points mentioned in lines 3, 4 and 5 above were in conformance with the rules of the Michigan Board of Land Surveyors or by a Decree of a Court of Law; established, re-established, monumented, re-monumented, recovered, found as expressed below:

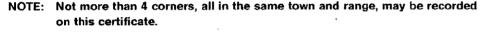

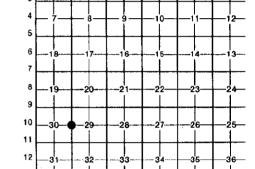

Description of original monument and accessories and/or subsequent restoration:

1845: Established by James A. Mullett, G.L.O. Survey. A spruce 6" in

diameter was used as the corner with no references.

1977: Survey by Wm. P. Richards. Set 5/8" Iron Rod by single proportion between corners north and south.

B. Description of corner evidence found and/or method applied in restoring or reestablishing corner:

1994: Found 5/8" Iron Rod 3' below the shoulder of the road. This corner lies 15 feet east of the centerline of John Martin Road.

> ACCEPTED BY THE MACKINAC COUNTY SURVEY PEER GROUP AS THE OFFICIAL CORNER UNDER P.A. 345 OF 1990 AT A MEETING HELDON 6-16-94

C. Description of monument for corner and accessories established to perpetuate locating the position of the corner: 1994: Set Mackinac County Remonumentation Corner

A55/8" by 24" Iron Rod with a 3" aluminum cap stamped to identif set 6" below the road gravel surface.

	Reference	ced:					
aug.:	N54°E -	19.60	feet	_	20 <b>"</b>	Spruce	(Exist.)
Ü							(Exist.)
Ü							(Exist.)
7)	S65°E -	26.75	feet	-	10"	Spruce	

Pad B. letter Signed by \_

D-0317 REVISED JAN., 194

SONAL

Surveyor's Michigan License No. \_\_\_