

SURVEY & REMONUMENTATION
APR 10 1995
COMMISSION

LAND CORNER RECORDATION CERTIFICATE
Filing Requirement of Act 74, Mich. P.A. 1970

For corners in
Mackinac
(County)

Located In:

Corner Code ##

- 1. Public Land Survey T 42N R 4W C-11
 T _____ R _____
 T _____ R _____
 T _____ R _____
- 2. Property Controlling S _____ T _____ R _____
 in Section S _____ T _____ R _____
- 3. Miscellaneous S _____ T _____ R _____
 Property in Sec. S _____ T _____ R _____
- 4. Lot No. _____, Recorded Plat _____
- 5. Private Claims _____

RECEIVED & FILED
DAVID B. GUTHRIE
MACKINAC COUNTY
NOV 09 1994
AM
REGISTER OF DEEDS

Register of Deeds Stamp & File Number

I, David B. Guthrie in a field survey on June 15, 1994, do hereby certify that under requirements of P.A. 74, Michigan P.A. of 1970, the corner points mentioned in lines 1 and 2 above were in conformance with regulations and rules therefore as required in the current manual of survey instructions of the United States Department of the Interior, Bureau of Land Management or by a decree of a Court of Law and/or that the corner points mentioned in lines 3, 4 and 5 above were in conformance with the rules of the Michigan Board of Land Surveyors or by a Decree of a Court of Law; established, re-established, monumented, re-monumented, recovered, found as expressed below:

NOTE: Not more than 4 corners, all in the same town and range, may be recorded on this certificate.

A	B	C	D	E	F	G	H	I	J	K	L	M
2	6	5	4	3	2	1						
3												
4	7	8	9	10	11	12						
5												
6	18	17	16	15	14	13						
7												
8	19	20	21	22	23	24						
9												
10	30	29	28	27	26	25						
11		●										
12	31	32	33	34	35	36						
13												

- A. Description of original monument and accessories and/or subsequent restoration:
- 1845: Established by James A. Mullett, G.L.O. Survey. Set post and referenced:
 Cedar 6/N44W/28 Cedar 8/S27E/15
 - ±1960: MDSH Survey. Found 1/2" Iron Pipe
 - 1964: Survey by T.L. Jackson. Found 1/2" Iron Pipe raised with 1/2" Iron Pipe.
 - 1973: Survey by Mary Feindt.
 - 1977: Survey by Larry Feindt. Found 3/4" Iron Pipe in Monument Box.
 - 1980: Survey by Orlando Doyle. Found 3/4" Iron Pipe in Box in Pavement.
 - 1983: Survey by Beryl M. Jones. Found 3/4" Iron Pipe in Monument Box.


- B. Description of corner evidence found and/or method applied in restoring or reestablishing corner:
- 1994: Found 1/2" Iron Pipe in Monument Box

ACCEPTED BY THE MACKINAC COUNTY
SURVEY PEER GROUP AS THE
OFFICIAL CORNER UNDER P.A.
345 OF 1990 AT A MEETING
HELD ON 8-16-94

James H. Strang

- C. Description of monument for corner and accessories established to perpetuate locating the position of the corner:
- 1994: Set Mackinac County Remonumentation Corner.
 A 5/8" by 24" Iron Rod with a 3" aluminum cap stamped to identify the
 corner set within a monument box.

- Referenced:
- S02°W - 38.02 feet - 10" Cedar (Exist.)
 - S15°E - 40.03 feet - 10" Spruce (Exist.)
 - S32°E - 49.85 feet - 15" Spruce (Exist.)
 - S24°W - 42.85 feet - 4" Ash
 - S28°E - 45.50 feet - 6" Cedar

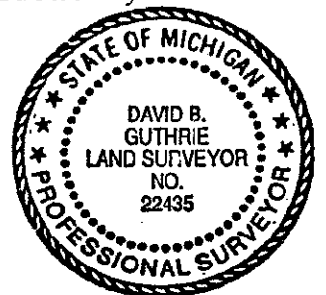

Signed by David B. Guthrie
Surveyor's Michigan License No. 22435

Date Oct. 21, 1994

D-0318