1994 Mackinac County Remonumentation Corner.

SURVEY & REMONUMENTATION
APR 1 0 1995
COMMISSION

LAND CORNER RECORDATION CERTIFICATE
Filing Requirement of Act 74, Mich. P.A. 1970

RECEIVED & FILED
NOV 09 1994
AM PM
7|8|9|10|11|12|1|2|3|4|5|6

For corners in Mackinac (County)

	Located In:	Corner Code ##
1. Public Land Survey	T 42N R 4W	E-12
	T ___ R ___	
	T ___ R ___	
	T ___ R ___	
2. Property Controlling	S ___ T ___ R ___	
in Section	S ___ T ___ R ___	
3. Miscellaneous	S ___ T ___ R ___	
Property in Sec.	S ___ T ___ R ___	

Register of Deeds Stamp & File Number

4. Lot No. _____ , Recorded Plat _____
5. Private Claims _____

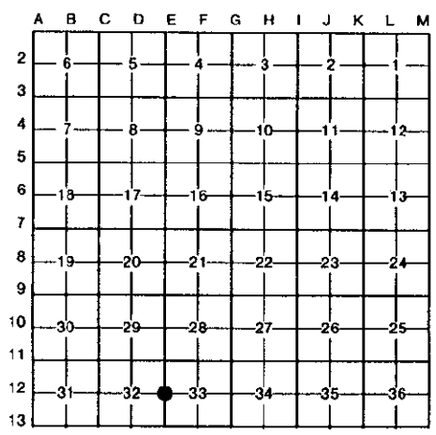

I, David B. Guthrie, in a field survey on June 21, 19 94, do hereby certify that under requirements of P.A. 74, Michigan P.A. of 1970, the corner points mentioned in lines 1 and 2 above were in conformance with regulations and rules therefore as required in the current manual of survey instructions of the United States Department of the Interior, Bureau of Land Management or by a decree of a Court of Law and/or that the corner points mentioned in lines 3, 4 and 5 above were in conformance with the rules of the Michigan Board of Land Surveyors or by a Decree of a Court of Law; established, re-established, monumented, re-monumented, recovered, found as expressed below:

NOTE: Not more than 4 corners, all in the same town and range, may be recorded on this certificate.

A. Description of original monument and accessories and/or subsequent restoration:
1845: Established by James A. Mullett, G.L.O. Survey. Set post and referenced:
Beech 16/N58W/21 Fir 10/S58E/14
1980: Survey by Orlando Doyle. Set 3/4" Iron Bar.
1982: Survey by Lawrence Feindt. Found 3/4" Iron Bar.

B. Description of corner evidence found and/or method applied in restoring or reestablishing corner:
1994: Found 3/4" Iron Bar.

ACCEPTED BY THE MACKINAC COUNTY SURVEY PEER GROUP AS THE OFFICIAL CORNER UNDER P.A. 345 OF 1990 AT A MEETING HELD ON 8-16-94
James H Granger

11-09-94

C. Description of monument for corner and accessories established to perpetuate locating the position of the corner:
1994: Set Mackinac County Remonumentation Corner.
A 5/8" by 24" Iron Rod with a 3" aluminum cap stamped to identify the corner set within a monument box.

Referenced:
N52°E - 45.75 feet - Utility Pole (Exist.)
S33°W - 66.48 feet - 6" Ash (Exist.)
N41°W - 39.92 feet - Red Brick in Wall (Exist.)
S40°E - 32.82 feet - 4" Apple

STATE OF MICHIGAN
DAVID B. GUTHRIE
LAND SURVEYOR
NO. 22435
PROFESSIONAL SURVEYOR

Signed by David B. Guthrie Date Oct. 21, 1994
Surveyor's Michigan License No. 22435

11-09-94

FORM APPROVED BY MICHIGAN STATE BOARD OF LAND SURVEYORS, JAN. 28, 1971
REVISED MAY 14, 1975
REVISED JAN., 1983

D-0325