

**LAND CORNER RECORDATION CERTIFICATE**  
**Filing Requirement of Act 74, Mich. P.A. 1970**

For corners in Mackinac (County) Located In: \_\_\_\_\_ Corner Code # \_\_\_\_\_

1. Public Land Survey T 42N R 4W F-13  
 T \_\_\_\_\_ R \_\_\_\_\_  
 T \_\_\_\_\_ R \_\_\_\_\_  
 T \_\_\_\_\_ R \_\_\_\_\_

2. Property Controlling S \_\_\_\_\_ T \_\_\_\_\_ R \_\_\_\_\_  
 in Section S \_\_\_\_\_ T \_\_\_\_\_ R \_\_\_\_\_

3. Miscellaneous S \_\_\_\_\_ T \_\_\_\_\_ R \_\_\_\_\_  
 Property in Section S \_\_\_\_\_ T \_\_\_\_\_ R \_\_\_\_\_

4. Lot No. \_\_\_\_\_, Recorded Plat \_\_\_\_\_

5. Private Claims \_\_\_\_\_

**RECEIVED & FILED**  
**DIANE FRANKOVICH**  
 MACKINAC COUNTY REGISTRE OF DEEDS

NOV 15 1996  
 AM \_\_\_\_\_ PM \_\_\_\_\_  
 7|8|9|10|11|12|1|2|3|4|5|6

Register of Deeds Stamp & File Number

I, David B. Guthrie, in a field survey on October 1, 1996, do hereby certify that under requirements of P.A. 74, Michigan P.A. of 1970, the corner points mentioned in lines 1 and 2 above were in conformance with regulations and rules therefore as required in the current manual of survey instructions of the United States Department of the Interior, Bureau of Land Management or by a decree of a Court of Law and/or that the corner points mentioned in lines 3, 4 and 5 above were in conformance with the rules of the Michigan Board of Professional Surveyors or by a Decree of a Court of Law; established, re-established, monumented, re-monumented, recovered, found as expressed below:

**NOTE: Not more than 4 corners, all in the same town and range, may be recorded on this certificate.**

**A. Description of original monument and accessories and/or subsequent restoration:**

1840: G.L.O. Survey by Wm. Burt - Set Post and Referenced  
 Sugar 8 - N49E - 35 / Sugar 14 - N51W - 15

**B. Description of corner evidence found and/or method applied in restoring or reestablishing corner:**

1996: Found no evidence of corner location. Set Corner by single proportion between the Northwest and North 1/4 Corners of Section 4, T41N-R4W.

**SURVEY &  
 REMONUMENTATION**

MAY 20 1997

**COMMISSION**


ACCEPTED BY THE MACKINAC COUNTY  
 SURVEY PEER GROUP AS THE  
 OFFICIAL CORNER UNDER P.A.  
 345 OF 1990 AT A MEETING  
 HELDON 8-20-96

*James H. Kranger*

**C. Description of monument for corner and accessories established to perpetuate locating the position of the corner:**

1996: Set a 5/8" x 24" Iron Rod with an Aluminum Cap stamped to identify the corner.

Referenced: East - 1/2" Iron Rod with 3" Alum. Cap - 26.40 Feet  
 N45°E - Utility Pole - 51.90 Feet  
 S40°E - Utility Pole - 48.71 Feet  
 S75°W - Wood Sign Post - 56.30 Feet

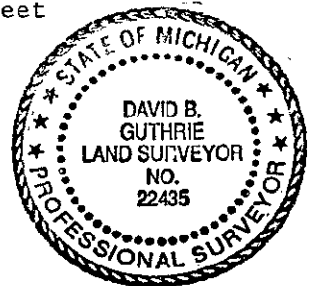

Signed by *David B. Guthrie*

Date Oct. 2, 1996

Surveyor's Michigan License No. 22435