

LAND CORNER RECORDATION CERTIFICATE
Filing Requirement of Act 74, Mich. P.A. 1970

For corners in Mackinac Located In: _____ Corner Code # _____
(County)

1. Public Land Survey T 42N R 4W _____ G-13
T _____ R _____
T _____ R _____
T _____ R _____

2. Property Controlling S _____ T _____ R _____
in Section S _____ T _____ R _____

3. Miscellaneous S _____ T _____ R _____
Property in Section S _____ T _____ R _____

RECEIVED & FILED
DIANE FRANKOVICH
MACKINAC COUNTY REGISTER OF DEEDS

NOV 15 1996
AM _____ PM _____
7|8|9|10|11|12|1|2|3|4|5|6

Register of Deeds Stamp & File Number

4. Lot No. _____, Recorded Plat _____
5. Private Claims _____

A	B	C	D	E	F	G	H	I	J	K	L	A
2	6	5	4	3	2	1						
3												
4	7	6	5	4	3	2	1					
5												
6	18	17	16	15	14	13						
7												
8	19	20	21	22	23	24						
9												
10	30	29	28	27	26	25						
11												
12	31	32	33	34	35	36						
13												

I, David B. Guthrie, in a field survey on October 1, 1996, do hereby certify that under requirements of P.A. 74, Michigan P.A. of 1970, the corner points mentioned in lines 1 and 2 above were in conformance with regulations and rules therefore as required in the current manual of survey instructions of the United States Department of the Interior, Bureau of Land Management or by a decree of a Court of Law and/or that the corner points mentioned in lines 3, 4 and 5 above were in conformance with the rules of the Michigan Board of Professional Surveyors or by a Decree of a Court of Law; established, re-established, monumented, re-monumented, recovered, found as expressed below:

NOTE: Not more than 4 corners, all in the same town and range, may be recorded on this certificate.

A. Description of original monument and accessories and/or subsequent restoration:

1840: G.L.O. Survey by Wm. Burt - Set Post and Referenced
Birch 14 - N46E - 20 / Birch 26 - N13W - 40

B. Description of corner evidence found and/or method applied in restoring or reestablishing corner:

1996: Found 1" Iron Pipe 33 Feet West of the Northeast Corner of Section 4,
T41N-R4W.

SURVEY &
REMONUMENTATION

MAY 20 1997


COMMISSION

ACCEPTED BY THE MACKINAC COUNTY
SURVEY FEEL GROUP AS THE
OFFICIAL CORNER UNDER P.A.
345 OF 1990 AT A MEETING
HELD ON 8-20-96

James H. Granger

C. Description of monument for corner and accessories established to perpetuate locating the position of the corner:

1996: Placed a 5/8" x 24" Iron Rod with an Aluminum Cap stamped to identify the corner in a 1" Iron Pipe.
Referenced: S25°W - Utility Pole - 36.82 feet
N45°W - 4" Spruce - 67.90 feet
East - 1/2" Iron Rod with 3" Alum. Cap - 33.00 feet
S15°E - 16" Maple - 113.40 feet

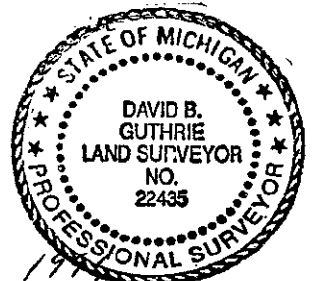

Signed by Pat B. [Signature]

Date Oct. 2 1996

Surveyor's Michigan License No. 22435