

LAND CORNER RECORDATION CERTIFICATE
Filing Requirement of Act 74, Mich. P.A. 1970

For corners in Mackinac (County) Located In: _____ Corner Code # _____

1. Public Land Survey T 42N R 4W J-11
 T _____ R _____
 T _____ R _____
 T _____ R _____

2. Property Controlling S _____ T _____ R _____
 in Section S _____ T _____ R _____

3. Miscellaneous S _____ T _____ R _____
 Property in Section S _____ T _____ R _____

4. Lot No. _____, Recorded Plat _____

5. Private Claims _____

RECEIVED & FILED
DIANE FRANKOVICH
 MACKINAC COUNTY REGISTER OF DEEDS

OCT 29 1996
 AM _____ PM _____
 7|8|9|10|11|12|1|2|3|4|5|6

Register of Deeds Stamp & File Number

	A	B	C	D	E	F	G	H	I	J	K	L	M
2	6		5		4		3		2		1		
3													
4	7		8		9		10		11		12		
5													
6	18		17		16		15		14		13		
7													
8	19		20		21		22		23		24		
9													
10	30		29		28		27		26		25		
11													
12	31		32		33		34		35		36		
13													

I, David B. Guthrie in a field survey on October 9, 19 96, do hereby certify that under requirements of P.A. 74, Michigan P.A. of 1970, the corner points mentioned in lines 1 and 2 above were in conformance with regulations and rules therefore as required in the current manual of survey instructions of the United States Department of the Interior, Bureau of Land Management or by a decree of a Court of Law and/or that the corner points mentioned in lines 3, 4 and 5 above were in conformance with the rules of the Michigan Board of Professional Surveyors or by a Decree of a Court of Law; established, re-established, monumented, re-monumented, recovered, found as expressed below:

NOTE: Not more than 4 corners, all in the same town and range, may be recorded on this certificate.

A. Description of original monument and accessories and/or subsequent restoration:
 1845: G.L.O. Survey by J.A. Mullett - Set Post and Referenced

B. Description of corner evidence found and/or method applied in restoring or reestablishing corner:
 1996: Found no evidence of corner. Set a 5/8" Iron Rod by East West proportionate distance between the North 1/4 Corner Section 33 and the Northeast Corner of Section 35, in the center of Charles Moran Road.

SURVEY & REMONUMENTATION

MAY 20 1997

COMMISSION


ACCEPTED BY THE MACKINAC COUNTY SURVEY PEER GROUP AS THE OFFICIAL CORNER UNDER P.A. 345 OF 1990 AT A MEETING HELD ON 8-26-96

James H. Dranger

C. Description of monument for corner and accessories established to perpetuate locating the position of the corner:

1996: Set a 5/8" x 24" Iron Rod with an Aluminum Cap stamped to identify the corner.

- Referenced: N35°W - 7" Spruce - 47.29 feet
- N35°E - 4" Cedar - 43.93 feet
- S30°E - 8" Spruce - 43.39 feet
- S50°W - 7" Spruce - 44.85 feet

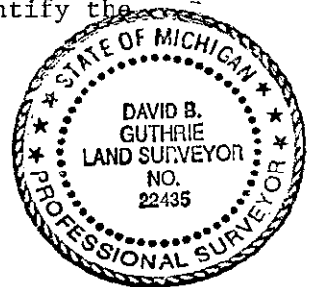

Signed by *David B. Guthrie*

Date Oct. 10, 1996

Surveyor's Michigan License No. 22435