

LAND CORNER RECORDATION CERTIFICATE

Filing Requirement of Act 74, Mich. P.A. 1970

For corners in Mackinac (County)

Located In:

Corner Code #

- 1. Public Land Survey T 42N R 4W K-11
2. Property Controlling in Section S T R
3. Miscellaneous Property in Section S T R
4. Lot No. , Recorded Plat
5. Private Claims

RECEIVED & FILED DIANE FRANKOVICH MACKINAC COUNTY REGIST. OF DEEDS

NOV 7 5 1996 AM PM 7|8|9|10|11|12|1|2|3|4|5|6

Register of Deeds Stamp & File Number

Grid table with columns A-M and rows 1-13. A dot is present in cell K11.

I, David B. Guthrie in a field survey on June 12, 1996, do hereby certify that under requirements of P.A. 74, Michigan P.A. of 1970, the corner points mentioned in lines 1 and 2 above were in conformance with regulations and rules therefore as required in the current manual of survey instructions of the United States Department of the Interior, Bureau of Land Management or by a decree of a Court of Law and/or that the corner points mentioned in lines 3, 4 and 5 above were in conformance with the rules of the Michigan Board of Professional Surveyors or by a Decree of a Court of Law; established, re-established, monumented, re-monumented, recovered, found as expressed below:

NOTE: Not more than 4 corners, all in the same town and range, may be recorded on this certificate.

A. Description of original monument and accessories and/or subsequent restoration:

1845: G.L.O. Survey by J.A. Mullett - Set Post and Referenced Birch 12 - S76E - 28 / Birch 10 - S30W - 38

B. Description of corner evidence found and/or method applied in restoring or reestablishing corner:

1996: Found 1/2" Iron Rod 3 Feet North of the centerline of Charles Moran Road.

SURVEY & REMONUMENTATION

MAY 20 1997


COMMISSION

ACCEPTED BY THE MACKINAC COUNTY SURVEY PEER GROUP AS THE OFFICIAL CORNER UNDER P.A. 345 OF 1990 AT A MEETING HELD ON 8-20-96

James H. Granger

C. Description of monument for corner and accessories established to perpetuate locating the position of the corner:

1996: Placed an Aluminum Cap stamped to identify the corner on a 5/8" Iron Rod. Referenced: N07°E - 4" Maple - 43.22 Feet S45°E - 7" Spruce - 50.21 Feet S28°W - 12" Cedar - 39.54 Feet N48°W - 15" Maple - 66.97 Feet

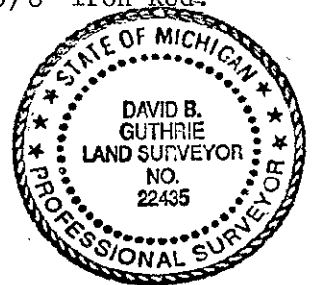

Signed by David B. Guthrie

Date Oct. 1, 1996

Surveyor's Michigan License No. 22435