

MAR 20 2000

LAND CORNER RECORDATION CERTIFICATE  
Filing Requirement of Act 74, Mich. P.A. 1970


SECTION

Mackinac County Remonumentation Corner

For corners in

Mackinac County	Located in:	Corner Code #
1. Public Land Survey	T42N R03W	A-9
	T42N R04W	M-9
	T R	
	T R	
2. Property Controlling in Section	S T R	
	S T R	
3. Miscellaneous Property in Sec.	S T R	
	S T R	
4. Lot No. , Recorded Plat		
5. Private Claims		

RECEIVED & FILED  
DIANE FRANKOVICH  
MACKINAC COUNTY CLERK OF DEEDS  
FEB 25 2000  
Register of Deeds Stamp & File Number

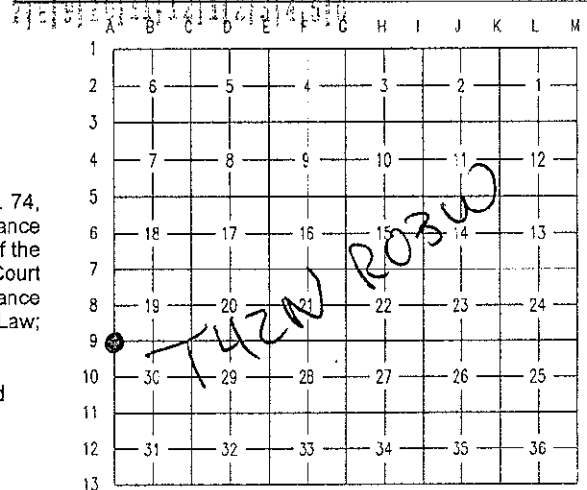

I, Neil E. Hill, in a field survey on 12-20-99, do hereby state that under requirements of P.A. 74, Michigan P.A. of 1970, the corner points mentioned in lines 1 and 2 above were in conformance with regulations and rules therefore as required in the current manual of survey instructions of the United States Department of the Interior, Bureau of Land Management or by a decree of a Court of Law and /or that the corner points mentioned in lines 3, 4 and 5 above were in conformance with the rules of the Michigan Board of Land Surveyors or by a Decree of a Court of Law; established, re-established, monumented, recovered, found as expressed below:

NOTE: Not more than 2 corners, all in the same town and range, may be recorded on this certificate.

A. Description of original monument and accessories and/or subsequent restoration:

1845 GLO Notes William A Burt	8" Cedar	N 18 W	22 lks
	10" Cedar	S 15 W	25 lks
1968 Harold Stockholm	10" Cedar	N 48 E	22.9'
Set 2" pipe w/ brass cap	8" Cedar	S 42 E	46.2'
by single proportion meas.	10" Cedar	N 84 W	21.6'
Plat of Gov't land survey #7	Sign Post	S 10 W	2.0'

ACCEPTED BY THE MACKINAC COUNTY SURVEY PEER GROUP AS THE OFFICIAL CORNER UNDER P.A. 345 OF 1990 AT A MEETING HELD ON 1-12-99  
Neil E. Hill

No Subsequent Information

B. Description of corner evidence found and/or method applied in restoring or reestablishing corner:


1999 Fd 2" pipe with 3" brass cap and 4 witnesses  
Accepted corner location

C. Description of monument for corner and accessories established to perpetuate locating the position of the corner:

Corner is 2" pipe with 3" brass cap

16" Cedar	N 48 E	23.08'
10" Cedar	S 42 E	46.06'
18" Cedar	N 84 W	21.67'
8" Cedar	N 15 W	17.61'

Hand-held GPS position:  
46-00-48 North  
84-44-15 West

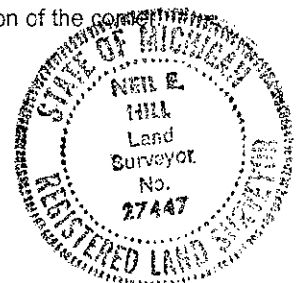

Bearings are compass bearings, corrected for declination, all distances are to a double-head nail in the side of the witness object unless otherwise noted.

Signed by Neil E. Hill P.S., P.C.

Date January 21 2000

Surveyor's Michigan License No. 27447