

1996 Mackinac County Remonumentation Corner

LAND CORNER RECORDATION CERTIFICATE
Filing Requirement of Act 74, Mich. P.A. 1970

For corners in Mackinac (County) Located In: _____ Corner Code # _____

1. Public Land Survey	T	<u>42N</u>	R	<u>4W</u>	<u>M-11</u>	
	T	_____	R	_____	_____	
	T	_____	R	_____	_____	
	T	_____	R	_____	_____	
2. Property Controlling in Section	S	_____	T	_____	R	_____
	S	_____	T	_____	R	_____
3. Miscellaneous Property in Section	S	_____	T	_____	R	_____
	S	_____	T	_____	R	_____

RECEIVED & FILED
DIANE FRANKOVICH
 MACKINAC COUNTY REGISTER OF DEEDS

NOV 7 5 1996
 AM _____ PM _____
 7|8|9|10|11|12|1|2|3|4|5|6

Register of Deeds Stamp & File Number

4. Lot No. _____, Recorded Plat _____
 5. Private Claims _____

	A	B	C	D	E	F	G	H	I	J	K	L	M
2	6	5	4	3	2	1							
3													
4	7	8	9	10	11	12							
5													
6	18	17	16	15	14	13							
7													
8	19	20	21	22	23	24							
9													
10	30	29	28	27	26	25							
11													
12	31	32	33	34	35	36							
13													

I, David B. Guthrie in a field survey on June 12, 1996, do hereby certify that under requirements of P.A. 74, Michigan P.A. of 1970, the corner points mentioned in lines 1 and 2 above were in conformance with regulations and rules therefore as required in the current manual of survey instructions of the United States Department of the Interior, Bureau of Land Management or by a decree of a Court of Law and/or that the corner points mentioned in lines 3, 4 and 5 above were in conformance with the rules of the Michigan Board of Professional Surveyors or by a Decree of a Court of Law; established, re-established, monumented, re-monumented, recovered, found as expressed below:

NOTE: Not more than 4 corners, all in the same town and range, may be recorded on this certificate.

A. Description of original monument and accessories and/or subsequent restoration:

1840: G.L.O. Survey by Wm. Burt - Set Post and Referenced Hemlock 7 - N58E - 12 / Fir 6 - S23W - 13

B. Description of corner evidence found and/or method applied in restoring or reestablishing corner:

1996: Found a 1/2" Iron Rod at the intersection of Charles Moran Road with a trail South.


SURVEY & REMONUMENTATION
 MAY 20 1997
COMMISSION

ACCEPTED BY THE MACKINAC COUNTY SURVEY PEER GROUP AS THE OFFICIAL CORNER UNDER P.A. 345 OF 1990 AT A MEETING HELDON 8-20-96

James H. Stranger

C. Description of monument for corner and accessories established to perpetuate locating the position of the corner:

1996: Placed an Aluminum Cap stamped to identify the corner on a 5/8" Iron Rod.
 Referenced: S45°W - Aluminum Mon. - 60.00 Feet
 S29°E - Utility Pole - 42.28 Feet
 N45°E - S.W. Cor. Cabin - 83.25 Feet
 N27°E - Utility Pole - 69.74 Feet
 N03°E - 1/2" Iron Rod - 33.00 Feet

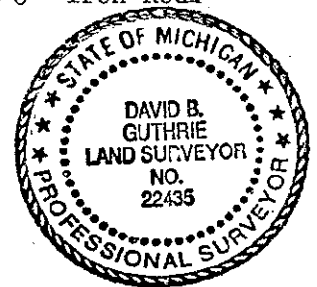

Signed by David B. Guthrie

Date Oct. 2, 1996

Surveyor's Michigan License No. 22435

FORM APPROVED BY MICHIGAN STATE BOARD OF PROFESSIONAL SURVEYORS, JAN. 28, 1971
 REVISED MAY 14, 1975
 REVISED JAN., 1983

E 0075