


JAN 21 1999

T43N R01W

SECTION

Marquette Twp.

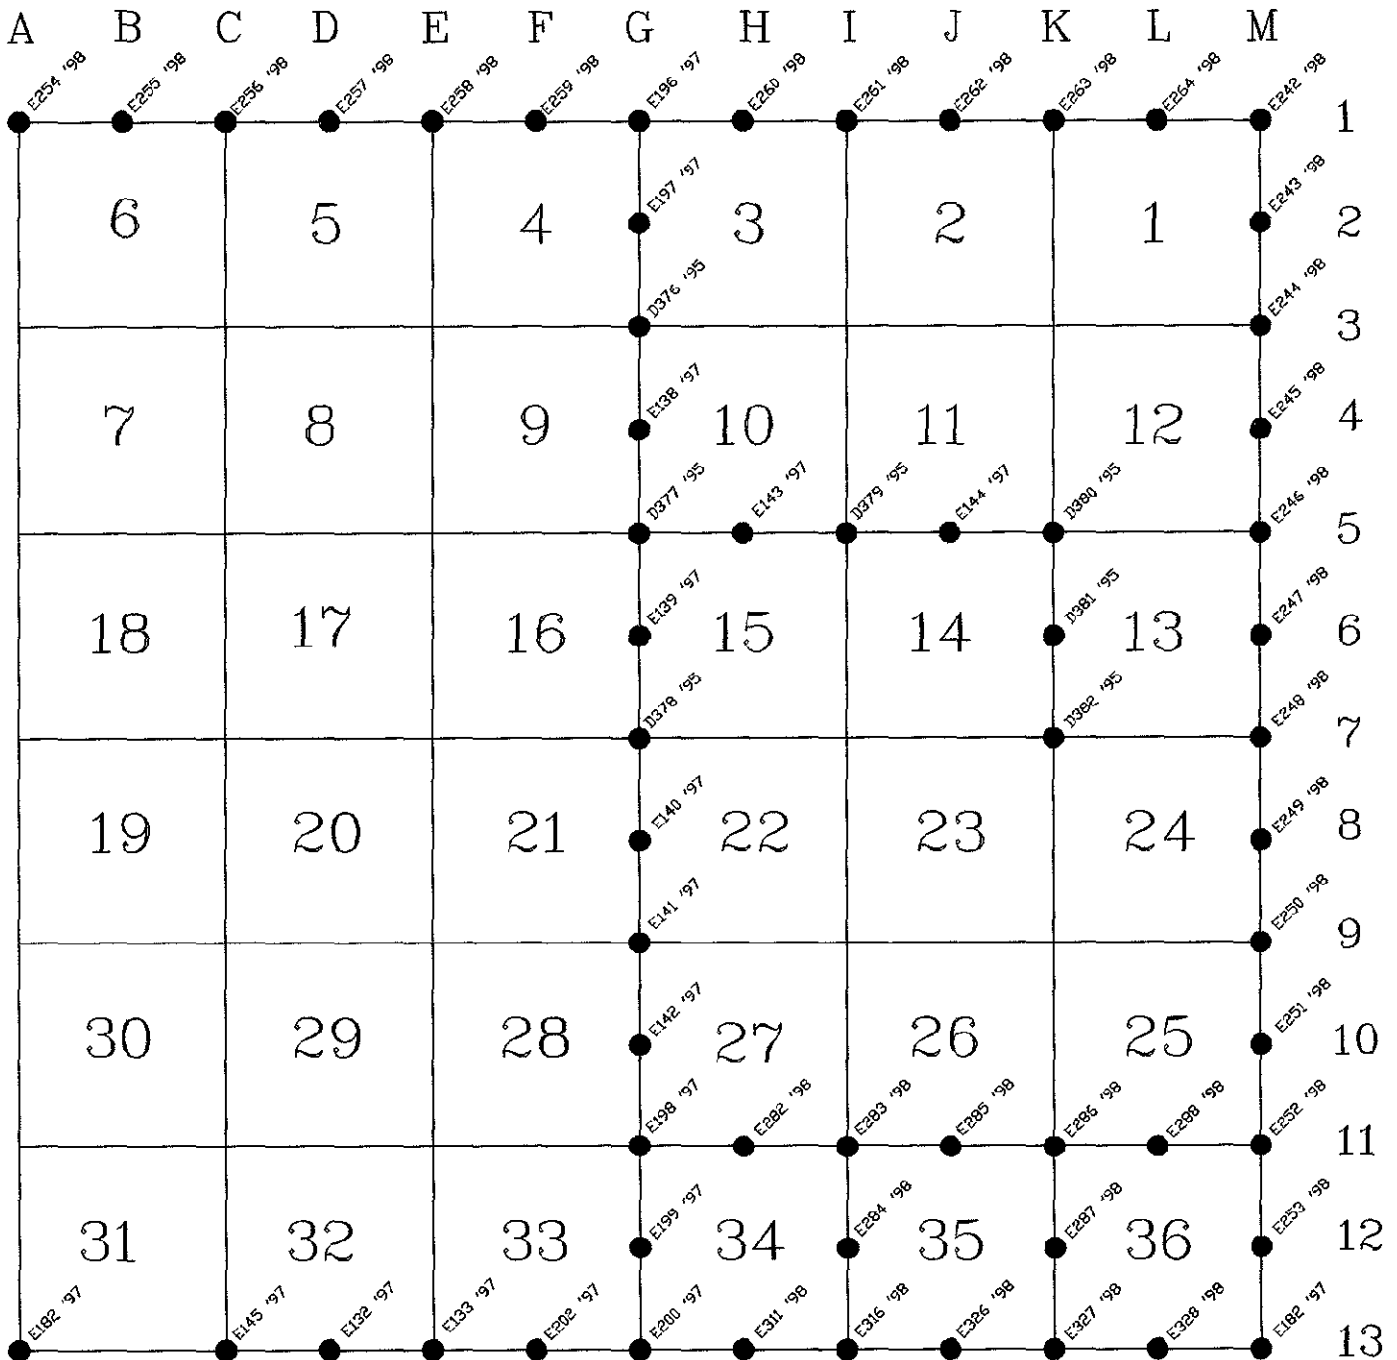

● Denotes Set ReMonumentation Corner in 1998

● Denotes Previously Set ReMonumentation Corner