


T43N R01W

Marquette Twp.

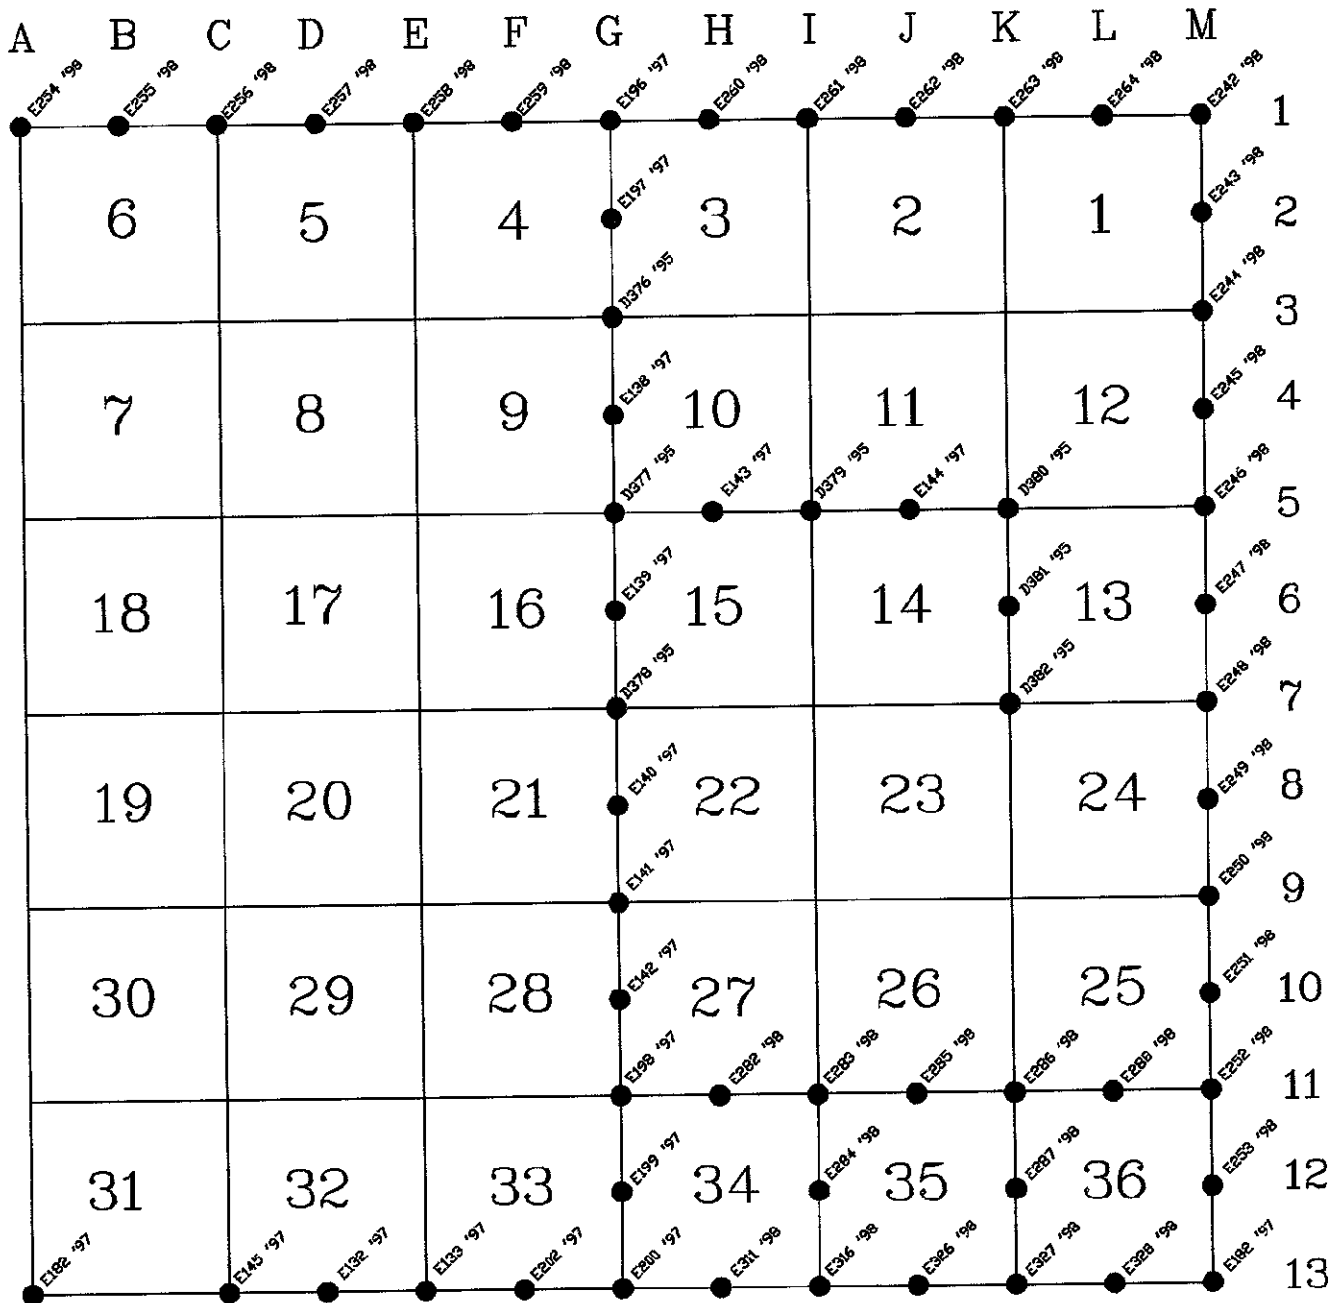

- Denotes Set ReMonumentation Corner in 1998
- Denotes Previously Set ReMonumentation Corner