SURVEY & REMONUMENTATION

APR 0 3 1998

1997 Mackinac County Remonumentation Corner

LAND CORNER RECORDATION CERTIFICATE

Filing Requirement of Act 74, Mich. P.A. 1970

For corners in SECTION

Mackinac (County) Located In: Corner Code #

1. Public Land Survey		T42N R 1W	C-1
		T43N R 1W	C-13 ✓
		T___ R___	
		T___ R___	
2. Property Controlling in Section	S___	T___ R___	
	S___	T___ R___	
3. Miscellaneous Property in Sec.	S___	T___ R___	
	S___	T___ R___	

RECEIVED & FILED DIANE ... MACKINAC COUNTY REGISTER OF DEEDS DEC 18 AM PM 7|8|9|10|11|12|1|2|3|4|5|6

Register of Deeds Stamp & File Number

4. Lot No. _____ , Recorded Plat _____

5. Private Claims _____

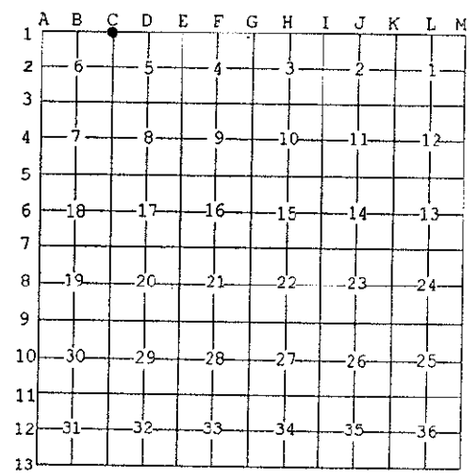

I, David B. Guthrie, in a field survey on July 18, 1997 do hereby state that under requirements of P.A. 74, Michigan P.A. of 1970, the corner points mentioned in lines 1 and 2 above were in conformance with regulations and rules therefore as required in the current manual of survey instructions of the United States Department of the Interior, Bureau of Land Management or by a decree of a Court of Law and /or that the corner points mentioned in lines 3, 4 and 5 above were in conformance with the rules of the Michigan Board of Land Surveyors or by a Decree of a Court of Law; established, re-established, monumented, recovered, found as expressed below:

NOTE: Not more than 2 corners, all in the same town and range, may be recorded on this certificate.

A. Description of original monument and accessories and/or subsequent restoration:

1840: G.L.O. Survey by Wm. Burt - Set Post and Referenced -
Sugar 10 / N57E / 41
Sugar 12 / N44W / 17

1975: Surveys by Thomas O'Brien - 1/2" Iron Pipe.
Certificates of Survey Recorded in Book 2, Page 186 and Book 2, Page 216.

B. Description of corner evidence found and/or method applied in restoring or reestablishing corner:

ACCEPTED BY THE MACKINAC COUNTY SURVEY PEER GROUP AS THE OFFICIAL CORNER UNDER P.A. 345 OF 1990 AT A MEETING HELD ON 11-21-97

1997: Remonumentation Survey by R.S. Scott Associates, Inc.
Found 3/4" Pipe at Road intersection.
Referenced -
(Exist.) N72°E - Stop Sign Post - 48.23'
S45°E - 1/2" Iron Rod - 45.78'
S45°W - Utility Pole - 49.48'
N23°W - 3" Aspen - 82.43'

This corner position is compatible with County and local surveys. This corner position is accepted as a careful and faithful perpetuation of the position of the original corner.

C. Description of monument for corner and accessories established to perpetuate locating the position of the corner:

1997: Placed 3" Mackinac County Cap stamped to identify the corner over 1/2" Iron Rod.
Referenced -
(Exist.) N72°E - Stop Sign Post - 48.23'
S45°E - 1/2" Iron Rod - 45.78'
S45°W - Utility Pole - 49.48'
N23°W - 3" Aspen - 82.43'

STATE OF MICHIGAN DAVID B. GUTHRIE LAND SURVEYOR NO. 22435 PROFESSIONAL SURVEYOR

Signed by David B. Guthrie Date 12-12-97

Surveyor's Michigan License No. 22435

FORM APPROVED BY MICHIGAN STATE BOARD OF PROFESSIONAL SURVEYORS, JAN. 28, 1971
REVISED MAY 14,1975
REVISED JAN., 1983
REVISED OCT., 1995