

**SURVEY &
REMONUMENTATION**

JAN 21 1999

SECTION

LAND CORNER RECORDATION CERTIFICATE
Filing Requirement of Act 74, Mich. P.A. 1970
Mackinac County Remonumentation Corner

For corners in

<u>Mackinac</u>	Located In:	Corner Code #
1. Public Land Survey	T <u>43N</u> R <u>1W</u>	<u>D-1</u>
	T ___ R ___	_____
	T ___ R ___	_____
	T ___ R ___	_____
2. Property Controlling in Section	S ___ T ___ R ___	
	S ___ T ___ R ___	
3. Miscellaneous Property in Sec.	S ___ T ___ R ___	
	S ___ T ___ R ___	
4. Lot No. _____, Recorded Plat _____		
5. Private Claims _____		

RECEIVED & FILED
DIANE FRANKOVICH
MACKINAC COUNTY REGISTER OF DEEDS

DEC 31 1998


AM _____ PM _____

7|8|9|10|11|12|1|2|3|4|5|6

Register of Deeds Stamp & File Number

I, Larry R. Rogers in a field survey on December 21, 1998, do hereby state that under requirements of P.A. 74, Michigan P.A. of 1970, the corner points mentioned in lines 1 and 2 above were in conformance with regulations and rules therefore as required in the current manual of survey instructions of the United States Department of the Interior, Bureau of Land Management or by a decree of a Court of Law and/or that the corner points mentioned in lines 3, 4 and 5 above were in conformance with the rules of the Michigan Board of Land Surveyors or by a Decree of a Court of Law; established, re-established, monumented, recovered, found as expressed below:

NOTE: Not more than 2 corners, all in the same town and range, may be recorded on this certificate.

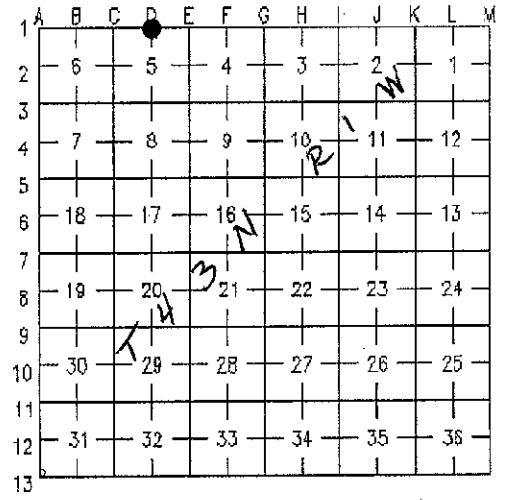

A. Description of original monument and accessories and/or subsequent restoration:
(D-1) North 1/4 corner of Section 5, Township 43 North, Range 1 West.
This corner was not set in the original G.L.O. survey. Found no evidence of corner position other than an existing fence on the East line of the "Cottle Cemetery" (the apparent North-South 1/4 line of Section 5). The standard South 1/4 corner of Section 32, Township 44 North, Range 1 West falls 10.8 feet West of cemetery fence - G.L.O. falling was 6.6 feet.

B. Description of corner evidence found and/or method applied in restoring or reestablishing corner:
(D-1) North 1/4 corner of Section 5, Township 43 North, Range 1 West.
This corner is being re-established as part of the Mackinac County Remonumentation Program. Corner position was re-established on line between the Southeast and Southwest corners of Section 32, Township 44 North, Range 1 West, and on the extension of the fenceline on the East side of "Cottle Cemetery". Corner was placed in a new monument box in the centerline of Townline Road (East-West, paved) and 10.8 feet East of the standard South 1/4 corner of Section 32, Township 44 North, Range 1 West.

C. Description of monument for corner and accessories established to perpetuate locating the position of the corner:
(D-1) North 1/4 corner of Section 5, Township 43 North, Range 1 West.
Corner is a 3/4" x 24" iron with plastic "County Remonumentation" cap inside a monument box in the centerline of Townline Road and the extension of the fenceline on the East side of "Cottle Cemetery".

Witnesses:

Utility Pole (PD2/70/50)	N42°E	40:00 feet
Chiseled "X" in top of corner metal fence post	S07°W	33.33 feet
4" Spruce	S82°W	117.07 feet
Corner Fence Post	N10°W	49.53 feet
S 1/4 Corner Section 32	West	10.8 feet

ACCEPTED BY THE MACKINAC COUNTY
SURVEY PEER GROUP AS THE
OFFICIAL CORNER UNDER P.A.
345 OF 1990 AT A MEETING
HELD ON 12-04-98 NEW



Signed by [Signature] Date 23 Dec 1998

Surveyor's Michigan License No. 29251

NOTE: Bearings are magnetic compass bearings not corrected for declination. Distances are to a nail in side of witness object unless noted.

FORM APPROVED BY MICHIGAN STATE BOARD OF PROFESSIONAL SURVEYORS, JAN. 28, 1971
REVISED MAY 14, 1975
REVISED JAN., 1983
REVISED OCT., 1985

Due to weather conditions the monument box will be set in the Spring of 1999.