

SURVEY & REMONUMENTATION

APR 03 1998

1997 Mackinac County Remonumentation Corner LAND CORNER RECORDATION CERTIFICATE Filing Requirement of Act 74, Mich. P.A. 1970

For corners in SECTION

Mackinac
(County)

Located In:

Corner Code #

1. Public Land Survey

T 42N R 1W E-1
T 43N R 1W E-13 ✓
T R
T R

2. Property Controlling in Section

S T R
S T R
S T R
S T R

3. Miscellaneous Property in Sec.

4. Lot No. _____, Recorded Plat _____
5. Private Claims _____

RECEIVED & FILED
DIANE FRANKOVICH
MACKINAC COUNTY CLERK OF DEEDS

DEC 18 1997

AM PM
718|9|10|11|12|1|2|3|4|5|6

Register of Deeds Stamp & File Number

I, David B. Guthrie, in a field survey on July 18, 1997 do hereby state that under requirements of P.A. 74, Michigan P.A. of 1970, the corner points mentioned in lines 1 and 2 above were in conformance with regulations and rules therefore as required in the current manual of survey instructions of the United States Department of the Interior, Bureau of Land Management or by a decree of a Court of Law and/or that the corner points mentioned in lines 3, 4 and 5 above were in conformance with the rules of the Michigan Board of Land Surveyors or by a Decree of a Court of Law; established, re-established, monumented, recovered, found as expressed below:

	A	B	C	D	E	F	G	H	I	J	K	L	M
1													
2	6			5		4			3			2	
3													
4	7			8		9			10			11	12
5													
6	18			17		16			15			14	13
7													
8	19			20		21			22			23	24
9													
10	30			29		28			27			26	25
11													
12	31			32		33			34			35	36
13													

A. Description of original monument and accessories and/or subsequent restoration:
1840: G.L.O. Survey by Wm. Burt - Set Post and Referenced -
Beech 12 / N41E / 17
Sugar 12 / N77W / 36

1982: Survey by Wm. L. Karr - Fd. and accepted 3/4" Pipe.
Referenced -

N05°E - 1/2" Iron Rod w/Cap #5434 - 33.07'
N12°E - 6" Maple - 33.65'
S09°E - 12" Beech - 26.76'
S38°W - 8" Twin Maple - 35.92'

N32°W - 10" Maple - 40.83'
L.C.R.C. Recorded in Book C, Page 43,
Certificate of Survey Recorded
in L. 3, P. 119.

B. Description of corner evidence found and/or method applied in restoring or reestablishing corner:
1997: Remonumentation Survey by R.S. Scott Associates, Inc.
Found 3/4" Pipe 2.5' North of Road C.L.


Referenced -
(Exist.) N30°W - 16" Maple - 41.15'
(Exist.) N11°E - 8" Maple - 33.68'
(Exist.) S05°E - 15" Beech - 26.68'
(Exist.) S39°W - 24" Maple - 36.04'
(Exist.) North - 1/2" Iron Rod - 33.00'

ACCEPTED BY THE MICHIGAN COUNTY
SURVEY PEER GROUP AS THE
OFFICIAL CORNER UNDER P.A.
345 OF 1990 AT A MEETING
HELD ON 11-21-97

This corner position is compatible with County and local surveys. This corner position is accepted as a careful and faithful perpetuation of the position of the original corner.

C. Description of monument for corner and accessories established to perpetuate locating the position of the corner:
1997: Placed 3" Mackinac County Cap stamped to identify the corner over the 1/2" Rod.

Referenced -
(Exist.) N30°W - 16" Maple - 41.15'
(Exist.) N11°E - 8" Maple - 33.68'
(Exist.) S05°E - 15" Beech - 26.68'
(Exist.) S39°W - 24" Maple - 36.04'
(Exist.) North - 1/2" Iron Rod - 33.00'

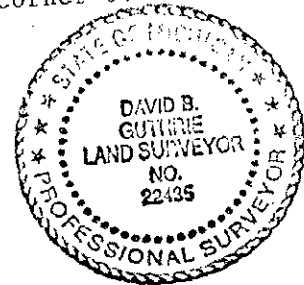

Signed by David B. Guthrie
Surveyor's Michigan License No. 22435

Date 12-12-97