

SURVEY & REMONUMENTATION

JAN 21 1999

SECTION

LAND CORNER RECORDATION CERTIFICATE
 Filing Requirement of Act 74, Mich. P.A. 1970
 Mackinac County Remonumentation Corner

For corners in


<u>Mackinac</u>	Located in:	Corner Code #
1. Public Land Survey	T <u>43N</u> R <u>1W</u>	<u>F-1</u>
	T ___ R ___	_____
	T ___ R ___	_____
	T ___ R ___	_____
2. Property Controlling in Section	S ___ T ___ R ___	
	S ___ T ___ R ___	
3. Miscellaneous Property in Sec.	S ___ T ___ R ___	
	S ___ T ___ R ___	

RECEIVED & FILED
 DIANE FRANKOVICH
 MACKINAC COUNTY REGISTER OF DEEDS

DEC 31 1998
 AM _____ PM _____
 7|8|9|10|11|12|1|2|3|4|5|6

Register of Deeds Stamp & File Number

4. Lot No. _____, Recorded Plat _____
 5. Private Claims _____

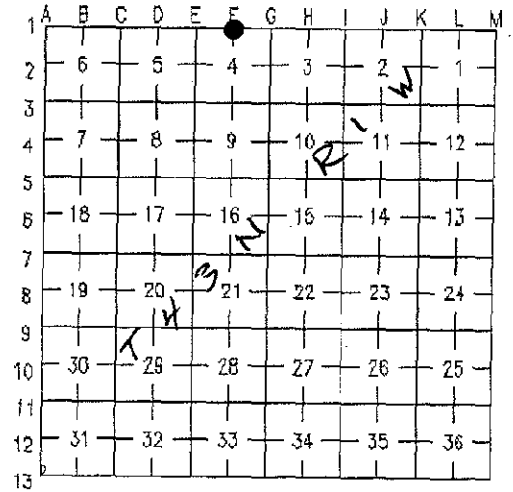

I, Larry R. Rogers in a field survey on December 21, 1998, do hereby state that under requirements of P.A. 74, Michigan P.A. of 1970, the corner points mentioned in lines 1 and 2 above were in conformance with regulations and rules therefore as required in the current manual of survey instructions of the United States Department of the Interior, Bureau of Land Management or by a decree of a Court of Law and/or that the corner points mentioned in lines 3, 4 and 5 above were in conformance with the rules of the Michigan Board of Land Surveyors or by a Decree of a Court of Law; established, re-established, monumented, recovered, found as expressed below:

NOTE: Not more than 2 corners, all in the same town and range, may be recorded on this certificate.

A. Description of original monument and accessories and/or subsequent restoration:
(F-1) North 1/4 Corner of Section 4, Township 43 North, Range 1 West.

This corner was not set during the original G.L.O. survey. In 1983, William L. Karr re-established the corner position on-line and midway between the Northeast and Northwest corners of Section 4, and filed a L.C.R.C. in the Mackinac County Corner Records. The corner fell 20.1 feet East of the standard South 1/4 corner of Section 33, Township 44 North, Range 1 West. (Computed G.L.O. falling was 20.13 feet).

B. Description of corner evidence found and/or method applied in restoring or reestablishing corner:
(F-1) North 1/4 Corner of Section 4, Township 43 North, Range 1 West.


This corner is being perpetuated as part of the Mackinac County Remonumentation Program. Recovered Karr 1/2" iron pin under new pavement and 20.10 feet East of Standard South 1/4 corner of Section 33. Placed new monument box over corner and established new witnesses.

C. Description of monument for corner and accessories established to perpetuate locating the position of the corner:
(F-1) North 1/4 Corner of Section 4, Township 43 North, Range 1 West.

Corner is a 1/2" iron pin in monument box in centerline of Townline Road, on the extension of a fenceline to the South and 20.10 feet East of South 1/4 corner (iron in monument box) of Section 33, Township 44 North, Range 1 West.

Witnesses:		
Utility Pole (64)	N54°W	51.43 feet
Fence Post	S18°W	48.31 feet
Fence Post	S54°E	94.40 feet
Punch Hole in West End of C.M.P.	S08°E	42.52 feet

ACCEPTED BY THE MACKINAC COUNTY SURVEY PEER GROUP AS THE OFFICIAL CORNER UNDER P.A. 345 OF 1990 AT A MEETING HELD ON 12-04-98 WEL

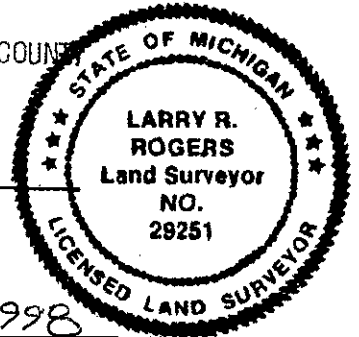

Signed by [Signature] Date 24 Dec 1998

Surveyor's Michigan License No. 29251

NOTE: Bearings are magnetic compass bearings not corrected for declination. Distances are to a nail in side of witness object unless noted.

FORM APPROVED BY MICHIGAN STATE BOARD OF PROFESSIONAL SURVEYORS. JAN. 28, 1971
 REVISED MAY 14, 1975
 REVISED JAN., 1983
 REVISED OCT., 1995