SECTION

1997 Mackinac County Remonumentation Corner

LAND CORNER RECORDATION CERTIFICATE

Filing Requirement of Act 74, Mich. P.A. 1970

For	corners	in
LOI	Conners	ш

Mackinac (County)	Located In:	Corner Code ##	RECEIVED 8 F
1. Public Land Survey	т <u>43N</u> R <u>1W</u> т R	G-4	DIENE FRANKO
	T R T R		DEC 18 19
2. Property Controlling in Section	S T R S T R		AM 7[8[5]201-1702]-12[3
Miscellaneous Property in Sec.	S T R S T R		Register of Deeds Stamp


11014 OF DEEDS

97 PM 141516

& File Number


4.	Lot No	Recorded Plat	_
5.	Private Claims		

<u>David B. Guthrie</u> in a field survey on <u>September 23</u> do hereby certify that under requirements of P.A. 74, Michigan P.A. of 1970, the corner points mentioned in lines 1 and 2 above were in conformance with regulations and rules therefore as required in the current manual of survey instructions of the United States Department of the Interior, Bureau of Land Management or by a decree of a Court of Law and/or that the corner points mentioned in lines 3, 4 and 5 above were in conformance with the rules of the Michigan Board of Land Surveyors or by a Decree of a Court of Law; established, re-established, monumented, re-monumented, recovered, found as expressed below:

 

A. Description of original monument and accessories and/or subsequent restoration:

```
1845: G.L.O. Survey by J.H. Mullet -
       Set Post and Referenced -
       Cedar 10 / N53E / 16
Cedar 14 / N69W / 11
```

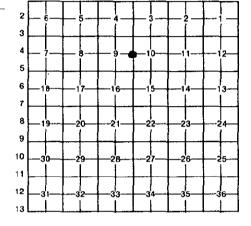

B. Description of corner evidence found and/or method applied in restoring or reestablishing corner:

1997: Remonumentation survey by R.S. Scott Associates, Inc. No monument was found for this corner. set this corner at the intersection of the N-S road and a fenceline East.

> ACCEPTED BY THE YEAR OF HE HEARTY SURVEY PEER CACUPAS IND OFFICIAL CORNER UNDER PA. **3**45 OF 1990 AT A MEETING HELD ON 11-21-97

C. Description of monument for corner and accessories established to perpetuate locating the position of the corner:

1997: Placed 3" Mackinac County Cap stamped to identify the corner over 1/2" Iron Rod. References ·

(Exist.) S70°E - 4" Spruce - 33.00' N90°W - 8" Spruce - 62.59' \$36°E - 4" Spruce - 60.05" (Exist.) N60°W - P.P. - 41.17'



Signed by .

12-12-97

Surveyor's Michigan License No. 22435

Date

SURVEY & REMONUMENTATION

MAR 1 3 1998

SECTION

```
(CONT'D FROM OTHER SIDE)

A. 1986: Survey by Ronald Bischer - P.K. Nail

Referenced -
S43°W - Anchor Pole - 55.55'
N55°E - Anchor Pole - 59.65'
N21°W - W. End of Culvert - 70.05'

1989: Survey by George J. Arendt - Fd. 1/2" Iron

Referenced -
S40°W - Pwr. Pole - 55.66'
N50°E - Pwr. Pole - 59.74'
N12°W - Pwr. Pole - 128.10'
S02°51'51"W - Re-Rod - 8.62'

1996: Survey by Ronald Bischer - Fd. 1/2" Iron Rod in Mon. Box.

Referenced -
S43°W - Anchor Pole - 55.55'
N55°E - Anchor Pole - 59.65'
N21°W - W. End of Culvert - 70.05'
S18°W - Power Pole - 66.60'
```