

MAR 13 1998

**SECTION**

1997 Mackinac County Remonumentation Corner  
**LAND CORNER RECORDATION CERTIFICATE**  
 Filing Requirement of Act 74, Mich. P.A. 1970

For corners in

<u>Mackinac</u> (County)	Located In:	Corner Code ##
1. Public Land Survey	T <u>43N R 1W</u>	<u>G-9</u>
	T _____ R _____	_____
	T _____ R _____	_____
	T _____ R _____	_____
2. Property Controlling in Section	S _____ T _____ R _____	_____
	S _____ T _____ R _____	_____
3. Miscellaneous Property in Sec.	S _____ T _____ R _____	_____
	S _____ T _____ R _____	_____

**RECEIVED & FILED**  
 DIANE FRANKOVICH  
 MACKINAC COUNTY CLERK OF DEEDS


DEC 18 1997

AM \_\_\_\_\_ PM \_\_\_\_\_  
 Register of Deeds Stamp & File Number

4. Lot No. \_\_\_\_\_, Recorded Plat \_\_\_\_\_  
 5. Private Claims \_\_\_\_\_

I, David B. Guthrie, in a field survey on July 18, 1997, do hereby certify that under requirements of P.A. 74, Michigan P.A. of 1970, the corner points mentioned in lines 1 and 2 above were in conformance with regulations and rules therefore as required in the current manual of survey instructions of the United States Department of the Interior, Bureau of Land Management or by a decree of a Court of Law and/or that the corner points mentioned in lines 3, 4 and 5 above were in conformance with the rules of the Michigan Board of Land Surveyors or by a Decree of a Court of Law; established, re-established, monumented, re-monumented, recovered, found as expressed below:

**NOTE: Not more than 4 corners, all in the same town and range, may be recorded on this certificate.**

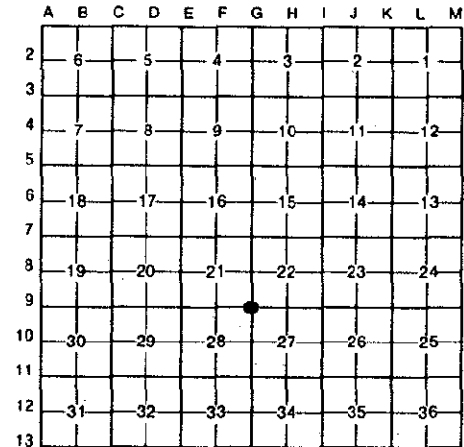

- A. Description of original monument and accessories and/or subsequent restoration:  
 1845: G.L.O. Survey by J.H. Mullett - Set Post and Referenced - Hemlock 20 / N52W / 29  
 Hemlock 24 / S51E / 21  
 1969: Survey by Billy D. Buckler - Placed 1 1/4"x30" Iron Pipe midway between Sec. Cors. one mile North and South and in center of N-S road. Position agrees with G.L.O. calls to North and West. Corner lies 3.4' South of south edge of house to East. S21°E - 22" Spruce - 102.4' / N89°E - 8" Spruce - 23.7' / N86°E - S.W. Cor. Hse. - 118.3  
 1996: Survey by Stephan J. Szyszkoski - Recovered 1 1/4"x30" Pipe set by Billy D. Buckler in 1969.  
 Referenced - S89°E - 14" Spruce - 24.2' / N88°E - S.W. Cor. Hse. - 118.3'  
 S81°E - 12" Spruce - 75.75' / S67°E - 6" Spruce - 33.35'

B. Description of corner evidence found and/or method applied in restoring or reestablishing corner:

- 1997: Remonumentation Survey by R.S. Scott Associates, Inc.  
 Found 1" Iron Pipe in road centerline.  
 Referenced -  
 (Exist.) N90°E - 12" Spruce - 24.27'  
 (Exist.) S83°E - 15" Spruce - 76.04'  
 (Exist.) S57°E - 7" Spruce - 33.10'  
 N25°E - 6" Balm - 59.88'

ACCEPTED BY THE MACKINAC COUNTY SURVEY PEER GROUP AS THE OFFICIAL CORNER UNDER P.A. 345 OF 1990 AT A MEETING HELD ON 11-21-97

This corner position is compatible with County and local surveys. This corner position is accepted as a careful and faithful perpetuation of the position of the original corner.

C. Description of monument for corner and accessories established to perpetuate locating the position of the corner:

- 1997: Placed 3" Mackinac County Cap stamped to identify the corner over 1/2" Iron Rod.  
 Referenced -  
 N90°E - 12" Spruce - 24.27'  
 S83°E - 15" Spruce - 76.04'  
 S57°E - 7" Spruce - 33.10'  
 N25°E - 6" Balm - 59.88'



Signed by David B. Guthrie

Date 12-12-97

Surveyor's Michigan License No. 22435