

JAN 21 1999

SECTION

LAND CORNER RECORDATION CERTIFICATE
Filing Requirement of Act 74, Mich. P.A. 1970
Mackinac County Remonumentation Corner

For corners in

Mackinac

Located In:

Corner Code #

1. Public Land Survey

T 43N R 1W

H-1

T R

T R

T R

2. Property Controlling in Section

S T R

S T R

3. Miscellaneous Property in Sec.

S T R

S T R

4. Lot No. , Recorded Plat

5. Private Claims

RECEIVED & FILED
DIANE FRANKOVICH
MACKINAC COUNTY DEPT. OF DEEDS

DEC 31 1998

AM PM
7|8|9|10|11|12|1|2|3|4|5|6

Register of Deeds Stamp & File Number

I, Larry R. Rogers in a field survey on December 21, 1998, do hereby state that under requirements of P.A. 74, Michigan P.A. of 1970, the corner points mentioned in lines 1 and 2 above were in conformance with regulations and rules therefore as required in the current manual of survey instructions of the United States Department of the Interior, Bureau of Land Management or by a decree of a Court of Law and/or that the corner points mentioned in lines 3, 4 and 5 above were in conformance with the rules of the Michigan Board of Land Surveyors or by a Decree of a Court of Law; established, re-established, monumented, recovered, found as expressed below:

NOTE: Not more than 2 corners, all in the same town and range, may be recorded on this certificate.

Grid table with columns A-M and rows 1-13. Contains handwritten annotations: 'H' at G3, 'N' at J3, 'R' at I4, 'N' at G7, 'H' at H8, 'N' at H9, 'H' at C9, 'N' at C10.

A. Description of original monument and accessories and/or subsequent restoration: (H-1) North 1/4 Corner of Section 3, Township 43 North, Range 1 West.

This corner was not set during the original G.L.O. survey. The standard South 1/4 corner of Section 34, Township 44 North, Range 1 West was accepted into the Chippewa County Remonumentation Program in 1994 and the North 1/4 corner of Section 3 was not monumented at that time. In 1996 Ronald Bischer found a 1/2" rod on the extension of a fenceline to the South and filed a L.C.R.C. in Liber E, Page 40 of the Mackinac County Records.

ACCEPTED BY THE MACKINAC COUNTY SURVEY PEER GROUP AS THE OFFICIAL CORNER UNDER P.A. 345 OF 1990 AT A MEETING HELD ON 12-04-98 NEW

B. Description of corner evidence found and/or method applied in restoring or reestablishing corner: (H-1) North 1/4 Corner of Section 3, Township 43 North, Range 1 West.


This corner is being perpetuated as part of the Mackinac County Remonumentation Program. Found badly bent 1/2" iron pin under new pavement. Replaced corner in previously located position from undisturbed traverse stations used in 1997 survey. Corner position checks with three recovered "Bischer" witnesses. Placed new monument box over corner. Position falls 24.0 feet East of South 1/4 corner of Section 34. (Computed G.L.O. is 22.44 feet.)

C. Description of monument for corner and accessories established to perpetuate locating the position of the corner: (H-1) North 1/4 Corner of Section 3, Township 43 North, Range 1 West.

Corner is a 3/4" x 24" iron with plastic "County Remonumentation" cap set in a monument box in the centerline of Townline Road (East-West, paved) and on the extension of an old fenceline to the South.

Witnesses:

Table with 3 columns: Witness, Bearing, Distance. Includes Center of Phone Splice Box, Corner Fence Post, Utility Pole, Fence Post, South 1/4 corner Section 34.

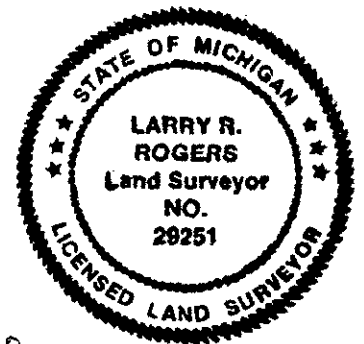

Signed by [Signature]

Date 28 Dec 1998

Surveyor's Michigan License No. 29251

NOTE: Bearings are magnetic compass bearings not corrected for declination. Distances are to a nail in side of witness object unless noted.