

JAN 21 1999

SECTION

LAND CORNER RECORDATION CERTIFICATE

Filing Requirement of Act 74, Mich. P.A. 1970

Mackinac County Remonumentation Corner

For corners in

Mackinac Located In: Corner Code #

1. Public Land Survey T 43N R 1W I-1
 T ___ R ___
 T ___ R ___
 T ___ R ___

2. Property Controlling S ___ T ___ R ___
 in Section S ___ T ___ R ___

3. Miscellaneous S ___ T ___ R ___
 Property in Sec. S ___ T ___ R ___

RECEIVED & FILED
 DIANE FRANKOVICH
 MACKINAC COUNTY REGISTER OF DEEDS

DEC 31 1998
 AM PM
 7|8|9|10|11|12|1|2|3|4|5|6

Register of Deeds Stamp & File Number

4. Lot No. _____, Recorded Plat _____
 5. Private Claims _____

I, Larry R. Rogers in a field survey on December 21, 1998, do hereby state that under requirements of P.A. 74, Michigan P.A. of 1970, the corner points mentioned in lines 1 and 2 above were in conformance with regulations and rules therefore as required in the current manual of survey instructions of the United States Department of the Interior, Bureau of Land Management or by a decree of a Court of Law and/or that the corner points mentioned in lines 3, 4 and 5 above were in conformance with the rules of the Michigan Board of Land Surveyors or by a Decree of a Court of Law; established, re-established, monumented, recovered, found as expressed below:

NOTE: Not more than 2 corners, all in the same town and range, may be recorded on this certificate.

1	A	B	C	D	E	F	G	H	I	J	K	L	M
2		6		5		4		3		2		1	
3													
4		7		8		9		10		11		12	
5													
6		18		17		16		15		14		13	
7													
8		19		20		21		22		23		24	
9													
10		30		29		28		27		26		25	
11													
12		31		32		33		34		35		36	
13													

A. Description of original monument and accessories and/or subsequent restoration:

(I-1) Northeast corner of Section 3, Township 43 North, Range 1 West (Closing Corner).

The original corner was placed in 1845 by James Mullet. Corner position was re-established in 1994 as part of the Chippewa County Remonumentation Program by doubling the distance from the Northwest corner of Section 3 to the North 1/4 corner of Section 3. The corner position was not monumented at that time - only used to help re-establish the standard corner common to Section 34 and 35, Township 44 North, Range 1 West. In 1996, Ronald Bischer found a 1/2" iron pin in monument box, origin unknown but position matches 1994 position.

B. Description of corner evidence found and/or method applied in restoring or reestablishing corner:

(I-1) Northeast corner of Section 3, Township 43 North, Range 1 West (Closing Corner).

This corner is being perpetuated as part of the Mackinac County Remonumentation Program.

Found and accepted a 1/2" iron pin with P.S. cap 22428 inside a monument box in the centerline of Townline Road (East-West, paved) and on the extension of the centerline of a "2-track" road to South. Corner is 17.82 feet East of standard corner common to Section 34 and 35, Township 44 North, Range 1 West. (G.L.O. falling is 17.82 feet),

C. Description of monument for corner and accessories established to perpetuate locating the position of the corner:


(I-1) Northeast corner of Section 3, Township 43 North, Range 1 West (Closing Corner).

Corner is a 1/2" iron pin with P.S. cap 22428 in a monument box.

Witnesses:

Utility Pole	N47°W	54.46 feet
Utility Pole	N89°E	264.58 feet
Water Well	N35°E	84.42 feet
Corner fence post	S53°W	40.64 feet
Standard Section corner	West	17.82 feet

ACCEPTED BY THE MACKINAC COUNTY
 SURVEY PEER GROUP AS THE
 OFFICIAL CORNER UNDER P.A.
 345 OF 1990 AT A MEETING
 HELD ON 12-04-98 WEH

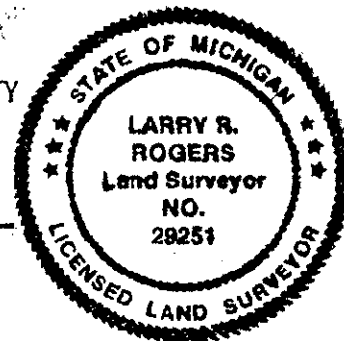

Signed by [Signature] Date 28 DEC 1998

Surveyor's Michigan License No. 29251

NOTE: Bearings are magnetic compass bearings not corrected for declination. Distances are to a nail in side of witness object unless noted.

FORM APPROVED BY MICHIGAN STATE BOARD OF PROFESSIONAL SURVEYORS, JAN. 28, 1971
 REVISED MAY 14, 1975
 REVISED JAN., 1983
 REVISED OCT., 1995