

1995 Mackinac County Remonumentation Corner

LAND CORNER RECORDATION CERTIFICATE  
Filing Requirement of Act 74, Mich. P.A. 1970

RECEIVED & FILED  
DIANE FRANKOVICH  
MACKINAC COUNTY REGISTER OF DEEDS

NOV - 7 1995  
AM 11:12 PM  
7|8|9|10|11|12|1|2|3|4|5|6

For corners in Mackinac (County) Located In: Corner Code #

1. Public Land Survey	T <u>43N</u> R <u>1W</u>	<u>K-7</u>
	T _____ R _____	_____
	T _____ R _____	_____
	T _____ R _____	_____
2. Property Controlling in Section	S _____ T _____ R _____	_____
	S _____ T _____ R _____	_____
3. Miscellaneous Property in Section	S _____ T _____ R _____	_____
	S _____ T _____ R _____	_____

Register of Deeds Stamp & File Number

4. Lot No. \_\_\_\_\_, Recorded Plat \_\_\_\_\_  
5. Private Claims \_\_\_\_\_

A	B	C	D	E	F	G	H	I	J	K	L	M
2	6	5	4	3	2	1						
3												
4	7	6	9	10	11	12						
5												
6	18	17	16	15	14	13						
7												
8	19	20	21	22	23	24						
9												
10	30	29	28	27	26	25						
11												
12	31	32	33	34	35	36						
13												

I, David B. Guthrie in a field survey on 8/2, 1995, do hereby certify that under requirements of P.A. 74, Michigan P.A. of 1970, the corner points mentioned in lines 1 and 2 above were in conformance with regulations and rules therefore as required in the current manual of survey instructions of the United States Department of the Interior, Bureau of Land Management or by a decree of a Court of Law and/or that the corner points mentioned in lines 3, 4 and 5 above were in conformance with the rules of the Michigan Board of Professional Surveyors or by a Decree of a Court of Law; established, re-established, monumented, re-monumented, recovered, found as expressed below:

NOTE: Not more than 4 corners, all in the same town and range, may be recorded on this certificate.

A. Description of original monument and accessories and/or subsequent restoration:

1845: Established by J.W. Mullett, G.L.O. Survey - Set post and referenced Tamk. 12 - N31E - 38 / Tamk. 14 - S33W - 25

1994: Survey by Ronald Bischer - Set 1/2" Iron Rod

B. Description of corner evidence found and/or method applied in restoring or reestablishing corner:

1995: Found 1/2" Iron Rod

SURVEY &  
REMONUMENTATION

DEC 01 1995


COMMISSION

ACCEPTED BY THE MACKINAC COUNTY  
SURVEY PEER GROUP AS THE  
OFFICIAL CORNER UNDER P.A.  
345 OF 1990 AT A MEETING  
HELD ON 9-18-95

*James H. Shroyer*

C. Description of monument for corner and accessories established to perpetuate locating the position of the corner:

1995: Placed a 3" Aluminum Cap stamped to identify the corner on a 1/2"x24" Iron Rod set 6" below the road surface.  
Referenced - (Exist.) S67°W - 8" Tamarack - 44.27 Feet  
(Exist.) N82°W - 4" Balsam - 54.08 Feet  
(Exist.) N65°W - 16" Tamarack - 47.91 Feet  
(Exist.) N83°E - 5" Spruce - 82.75 Feet

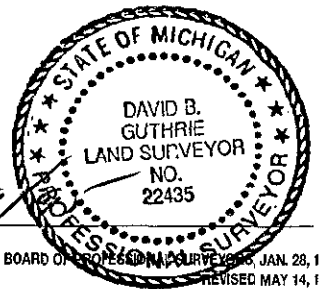

Signed by *David B. Guthrie* Date 9/19/95

Surveyor's Michigan License No. 22435