JAN 21 1999

LAND CORNER RECORDATION CERTIFICATE Filing Requirement of Act 74, Mich. P.A. 1970

SECTION

For corners in

Mackinac County Remonumentation Corner

Mackinac County	Located	l in:		Corner Code #
Public Land Survey		T43N T T T	R01W R R R	K-11
 Property Controlling in Section Miscellaneous 	S S S	T T T	R R R	

S

RECEIVED & FILED

DIAME FRANKOVICH

MACKINAC COUNT RECEIT OF DECOS

DEC 3 1 1998 AM 71816[10]11412[1]2[3]4[5]0

Register of Deeds Stamp & File Number


4. Lot No. , Recorded Plat

5. Private Claims


Property in Sec.

1, Neil E Hill, in a field survey on 12-21-98, do hereby state that under requirements of P.A. 74, Michigan P.A. of 1970, the corner points mentioned in lines 1 and 2 above were in conformance with regulations and rules therefore as required in the current manual of survey instructions of the United States Department of the Interior, Bureau of Land Management or by a decree of a Court of Law and for that the corner points mentioned in lines 3, 4 and 5 above were in conformance with the rules of the Michigan Board of Land Surveyors or by a Decree of a Court of Law; established, re-established, monumented, recovered, found as expressed below:

NOTE: Not more than 2 corners, all in the same town and range, may be recorded on this certificate.

 

1845 GLO Notes William A Burt	10" Sugar	N 84 W	25 lks
	12" R Oak	S 68 E	13 lks
1984 Harry Goodwin	24" R Oak	NW	39.2 ft
Fd Con Monument	8" Spruce	SE	43.4 ft
Liber 3, Page 244	Phone Box	SW	63.2 ft
1992 Stanley Kass	24" R Oak	N 25 W	39.60 ft
Fd Concrete Monument	8" Iron Wood	N 20 E	26.70 ft
Liber D, Page 161	Phone Box	S 57 W	61.52 ft

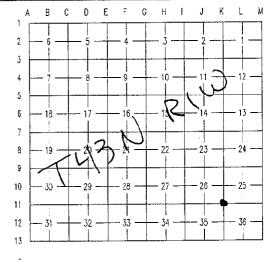

ACCEPTED BY THE MACKINAC COUNTY SURVEY PEER GROUP AS THE OFFICIAL CORNER UNDER RA. 345 OF 1990 AT A MEETING HELD ON 12-04-28 Note 14

B. Description of corner evidence found and/or method applied in restoring or reestablishing corner:

1998 Fd Con Monument and 3 witnesses Accepted corner location

C. Description of monument for corner and accessories established to perpetuate locating the position of the corner:

Corner is a ½" rod in a concrete monument in an E-W road Corner is approx 10' East of a gravel road to the South

24" R Oak	N 20 W	40.07
8" Ironwd	N 25 E	26.84'
5" Spruce	S 20 E	36.70'
10" R Oak		66.93'



Bearings are compass bearings, corrected for declination, all distances are to a double-headed nail in the side of the witness object unless otherwise noted.

igned by Weil E Hill PS.

Date 17-29-98

Surveyor's Michigan License No. 27447