LAND CORNER RECORDATION CERTIFICATE Filing Requirement of Act 74, Mich. P.A. 1970

MAR \$ 8 1999

Mackinac County Remonumentation Corner

For corners in

Corner Code # Mackinac County Located in: T42N R01W Public Land Survey T43N R01W R Т R Т

R T 2. Property Controlling S S Т R in Section S Miscellaneous Т R S Property in Sec.

4. Lot No.

, Recorded Plat

5. Private Claims

I, Neil E Hill, in a field survey on 12-21-98, do hereby state that under requirements of P.A. 74, Michigan P.A. of 1970, the corner points mentioned in lines 1 and 2 above were in conformance with regulations and rules therefore as required in the current manual of survey instructions of the United States Department of the Interior, Bureau of Land Management or by a decree of a Court of Law and /or that the corner points mentioned in lines 3, 4 and 5 above were in conformance with the rules of the Michigan Board of Land Surveyors or by a Decree of a Court of Law; established, re-established, monumented, recovered, found as expressed below:

NOTE: Not more than 2 corners, all in the same town and range, may be recorded on this certificate.

A. Description of original monument and accessories and/or subsequent restoration:

1845 GLO Notes James Mullett	6" Spruce	N 74 E	14 lks
	7" Spruce	N 43 W	22 lks
1998 R Bischer Fd 1/2" rod (H Goodwin?)	20" Hemlock 13" Hemlock 16" Hemlock 9" Cedar	S 27 E N 55 W S 38 W N 28 E	22.46' 7.35' 20.62' 13.64'

SECTION


RECEIVED & FILED

DIANE FRANKOVICH MACKINAC COUNTY REGISTEN OF DEEDS

MAR 17 1999

PM 71819110111112111213141516

Register of Deeds Stamp & File Number

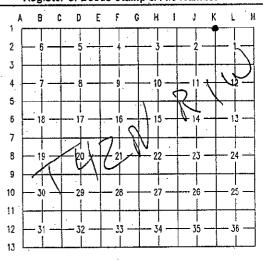

ACCEPTED BY THE MACKINAC COUNTY SURVEY PEER GROUP AS THE OFFICIAL CORNER UNDER PA 345 OF 1990 AT A MEETING HELD ON

> NEILE HILL Land

Surveyor Na

27647

D LAH

(Old witness) (Old witness)


B. Description of corner evidence found and/or method applied in restoring or reestablishing corner:

1998 Fd 1/2" rod and 4 old witnesses Accepted corner location Placed 4" Alum. remonumentation cap

C. Description of monument for corner and accessories established to perpetuate locating the position of the corn

Corner is a 1/2' rod with 4" Alum. remonumentation cap

22 46 (DId) 20" Hemlock S 27 E 13" Hemlock N 55 W 7.35 (Old) 16" Hemlock S 38 W 20.62 9" Cedar N 28 E 13.64

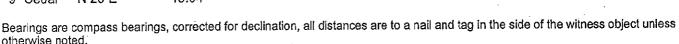

** NOTE: This corner is being re-recorded to correct an erroneous Range designation for the code K-13 (K-13 is R01W, Not R01E, as previously recorded in E-327)

R.S. R.C. Weil E.

Surveyor's Michigan License No. 27447

FORM APPROVED BY MICHIGAN STATE BOARD OF PROFESSIONAL SURVEYORS, JAN. 28, 1971 REVISED MAY 14, 1975 REVISED JAN., 1983 REVISED OCT., 1995