

**SURVEY & REMONUMENTATION**

JAN 21 1999

**SECTION**

**LAND CORNER RECORDATION CERTIFICATE**  
**Filing Requirement of Act 74, Mich. P.A. 1970**  
**Mackinac County Remonumentation Corner**

For corners in

Mackinac County	Located in:	Corner Code #
1. Public Land Survey	T43N R1W T43N R1E	<u>M-5</u> A-5 (Same corner Chippewa County)
	T R	
	T R	
2. Property Controlling in Section	S T R	
	S T R	
3. Miscellaneous Property in Sec.	S T R	
	S T R	
4. Lot No. , Recorded Plat		
5. Private Claims		


**RECEIVED & FILED**  
**DIANE FRANKOVICH**  
 MACQUINAC COUNTY REGISTER OF DEEDS

DEC 30 1998

AM PM  
 7|8|9|10|11|12|1|2|3|4|5|6

Register of Deeds Stamp & File Number

ACCEPTED BY THE MACKINAC COUNTY  
 SURVEY PEER GROUP AS THE  
 OFFICIAL CORNER UNDER P.A.  
 345 OF 1990 AT A MEETING  
 HELD ON 11-20-98 NEH

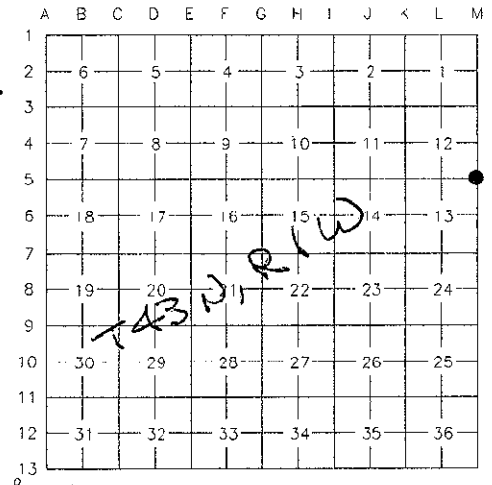

I, Keith R. Waters, in a field survey on November 11, 1998, do hereby state that under requirements of P.A. 74, Michigan P.A. of 1970, the corner points mentioned in lines 1 and 2 above were in conformance with regulations and rules therefore as required in the current manual of survey instructions of the United States Department of the Interior, Bureau of Land Management or by a decree of a Court of Law and /or that the corner points mentioned in lines 3, 4 and 5 above were in conformance with the rules of the Michigan Board of Land Surveyors or by a Decree of a Court of Law; established, re-established, monumented, recovered, found as expressed below:

NOTE: Not more than 2 corners, all in the same town and range, may be recorded on this certificate.

A. Description of original monument and accessories and/or subsequent restoration:

M-5 Corner Common to Secs. 12 & 13, T43N, R1W & Secs. 7 & 18, T43N, R1E

- 1840 - Original corner established by William A. Burt.
- 1960 - Liber 2, page 253, Chippewa County corner records. 1" iron pin in monument box.
- 1991 - MDOT notes indicate found 1" iron pin, witnesses prior to road construction.
- 1992 - LCRC, liber 7, page 357, Chippewa County corner records. Neil E. Hill, P.S. 27447, found a 1" iron pin in a monument box undisturbed after road construction. Witnesses:  
 Nail and MDOT tag in power pole, N40°W 79.94'  
 Nail and MDOT tag in guy pole, S75°E 74.60'  
 Nail and MDOT tag in power pole, S60°W 84.88'  
 Nail and MDOT tag in 13" elm, S50°E 116.11'  
 ¼ Corner, SOUTH 2641.74'
- 1994 - LCRC, liber 8, page 315, Chippewa County corner records. Keith R. Waters, P.S. 33142, found a 1" iron pin in a monument box and all record witness objects from 1992 LCRC.

B. Description of corner evidence found and/or method applied in restoring or reestablishing corner:

This corner is being perpetuated as part of the Mackinac County Remonumentation Program.  
 Found a 1" iron pin in a monument box and all record witnesses from 1992 and 1994 LCRC's.

C. Description of monument for corner and accessories established to perpetuate locating the position of the corner:

Found a 1" iron pin in a monument box at the corner location, which falls in the intersection of Highways M-129 north and south and M-48 to the east. Witnesses:

- Nail and MDOT tag in power pole, N40°W 79.94'
- Nail and MDOT tag in guy pole, S75°E 74.60'
- Nail and MDOT tag in power pole, S60°W 84.88'
- Nail and MDOT tag in 13" elm, S50°E 116.11'
- ½" iron with cap #27447 in monument box at ¼ corner 13-18, SOUTH 2641.74'



Signed by Keith R. Waters

Date 12-23-98

Surveyor's Michigan License No. 33142