SURVEY & REMONUMENTATION
FEB 16 1994
COMMISSION

LAND CORNER RECORDATION CERTIFICATE

Filing Requirement of Act 74, Mich. P.A. 1970

r corners in Mackinac (County)

	Located In:	Corner Code ##
Public Land Survey	T 43N R 5W	G-3
	T ___ R ___	
	T ___ R ___	
	T ___ R ___	
Property Controlling	S ___ T ___ R ___	
in Section	S ___ T ___ R ___	
Miscellaneous	S ___ T ___ R ___	
Property in Sec.	S ___ T ___ R ___	

RECEIVED & FILED
DIRECTOR OF REGISTER OF DEEDS
DEC 07 1993
AM PM
7|6|5|4|3|2|1|12|11|10|9|8|7|6|5|4|3|2|1

Register of Deeds Stamp & File Number

Lot No. _____ , Recorded Plat _____

Private Claims _____

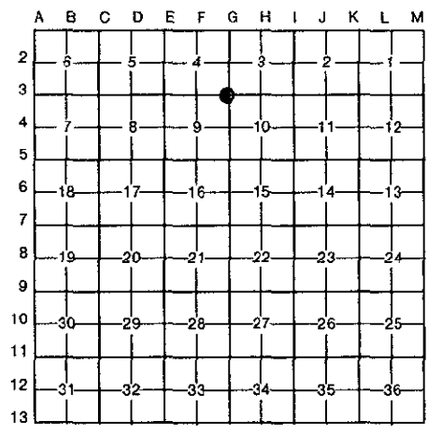

Neil E. Hill, in a field survey on October 1, 19 93,

hereby certify that under requirements of P.A. 74, Michigan P.A. of 1970, the corner points mentioned lines 1 and 2 above were in conformance with regulations and rules therefore as required in the rrent manual of survey instructions of the United States Department of the Interior, Bureau of Land anagement or by a decree of a Court of Law and/or that the corner points mentioned in lines 3, 4 and 5 ove were in conformance with the rules of the Michigan Board of Land Surveyors or by a Decree of a ourt of Law; established, re-established, monumented, re-monumented, recovered, found as xpressed below:

OTE: Not more than 4 corners, all in the same town and range, may be recorded on this certificate.

. Description of original monument and accessories and/or subsequent restoration:

1845: Corner positions were established H. Brevoort, Jr., D.S., in the original G.L.O. survey of T43N, R05W. Set a wood post and established the following references:
18" S. Maple N40E 26 links 12" S. Maple S30E 24 links

1990: The USDA Forest Service found no other record of any subsequent corner restoration.

. Description of corner evidence found and/or method applied in restoring or reestablishing corner:

1990: The USDA Forest Service found no original or any subsequent corner evidence. Corner position was re-established by survey at the point of intersection of centerlines where County Road 535 turns North and West.

1990: The USDA Forest Service set a 1/2" by 18" long rebar, capped with a plastic I.D. cap. Top of rebar is flush with road surface. Established the following references of which the Bearing Trees are blazed, scribed, painted, and tagged:
Utility pole EK3-295-16 N49E 52.3 feet 10" Maple S40E 106.0 feet
10" Maple S21W 41.2 feet 5" Maple N51W 93.7 feet

. Description of monument for corner and accessories established to perpetuate locating the position of the corner:

1993: Relaced with 5/8" X 30" rod with 3" aluminum cap.
Established additional references:
Post w/sign South 25.0 feet 1/2" rerod East 13.0 feet
Forest Road 3329 to the East, centerline of bituminous road West, West edge of gravel road North.

Upon review, the location and witnesses for the corner as recorded in Liber D-0129 (Corner Records), are sufficient to perpetuate the corner location.

Signed by Neil E. Hill P.S. P.C. Date October 15, 1993

Surveyor's Michigan License No. 27447

Remonumentation Surveyor

STATE OF MICHIGAN NEIL E. HILL Land Surveyor No. 27447 REGISTERED LAND SURVEYOR

FORM APPROVED BY MICHIGAN STATE BOARD OF LAND SURVEYORS, JAN. 28, 1971
REVISED MAY 14, 1975
REVISED JAN., 1983

D-0239