

LAND CORNER RECORDATION CERTIFICATE

FILING REQUIREMENT OF ACT 74, MICH. P.A. 1970

Mackinac Co.

Three Corners.

FOR CORNERS OF--:	LOCATED IN--:	CORNER CODE NUMBER
1. PUBLIC LAND SURVEY.....	T. 43 N. R. 6 X. W.	M-6, M-7, M-8
2. PROPERTY CONTROLLING IN SECTION.....	T. S. R. E. W.	
3. MISCELLANEOUS PROPERTY IN SECTION.....	T. S. R. E. W.	
4. LOT NO., RECORDED PLAT.....		
5. PRIVATE CLAIMS.....		

REGISTER OF DEEDS STAMP AND FILING NUMBER

I, Billy D. Buckler, do hereby certify that under requirements of P.A. 74, Michigan P.A. of 1970, the corner points mentioned in lines 1 and 2 above were, in a field survey on 9/9, 1977, established, re-established, monumented, re-monumented, recovered or restored as expressed below and in conformance with regulations and rules therefore as required in the current manual of survey instructions of the United States Department of the Interior, Bureau of Land Management or by a decree of a court of law. Furthermore, that the corner points mentioned in lines 3, 4 and 5 above were, in a field survey on _____, 19____, found, recovered, restored, established or re-established as expressed below and in conformance with the rules of the Michigan State Board of Registration for Land Surveyors or, by a Decree of a Court of law:


A. Description of original monument and accessories and/or subsequent restoration:
Corners set by Wm. A. Burt, D.S. on July 23, 1840.
M-6 Quarter corner on Eastside of Sec. 13, T43N R6W. Bearings were: Birch 10", S37°W, 15 lks. and Birch 15", N31°W, 27 lks.
M-7 Sec. Cor. 13-24, T43N R6W and 18-19, T43N R5W. Bearings were: Hemlock 12", S7°W, 43 lks and Hemlock 14, N61°E, 28 lks. and Cedar 20, N56°W, 15 lks. and Maple 10", S29°E, 10 lks.
M-8 Quarter corner on Eastside of Section 24. Bearings were: Hemlock 7" at corner and Birch 8", N10°W, 11 lks.

B. Description of corner evidence found and/or method applied in restoring or re-establishing corner:
M-6 Re-established corner midway bet. two Sec. Cors. on Range line. Found no evidence of original corner.
M-7 Corner re-established by single proportionate measure along the Range line from corners one mile North and one mile South. Found no evidence of original corner or evidence indicated by notes of Marcus Schaaf, R.L.S. in 1937.
M-8 Found remains of two pine stumps noted as witnesses by Marcus Schaaf, R.L.S. in 1937. Found remains of Hemlock stump at corner, as indicated by original record. Position checks with original corner 1/2 mile South.

C. Description of monument for corner and accessories established to perpetuate locating the position of the corner:
 Placed 1" pipe with 4" aluminium cap at all corners.

M-6 New Bearings: 14" Balsam, S59°E, 7.9' 10" Balsam, N55°W, 39.3'	M-7 New Bearings: 8" Spruce, N70°E, 12.7' 16" Spruce, S32°W, 22.2' 8" Spruce, N36°W, 12.2' Corner lies 20' East of a N-S trail road.	M-8 New Bearings: 16" Spruce, N73°W, 9.9' 8" Spruce, S7°W, 16.7' 8" Maple Group, N78°W, 72.0'
---	---	---

SIGNED BY: Billy D. Buckler DATE: 9/19/77
 SURVEYOR'S MICHIGAN REGISTRATION NO. 8887

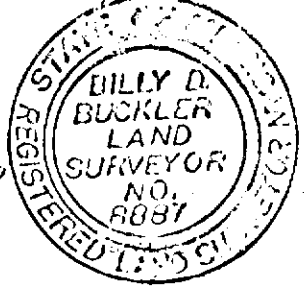

FOR STATE AND UNITED STATES AGENCIES:
 SIGNED BY: _____ DATE: _____
CHIEF OF SURVEY PARTY
 APPROVED AND SIGNED BY: _____ DATE: _____
MICHIGAN REGISTERED LAND SURVEYOR (SEAL)