


SEC. 9, T. 43N. R. 7W.

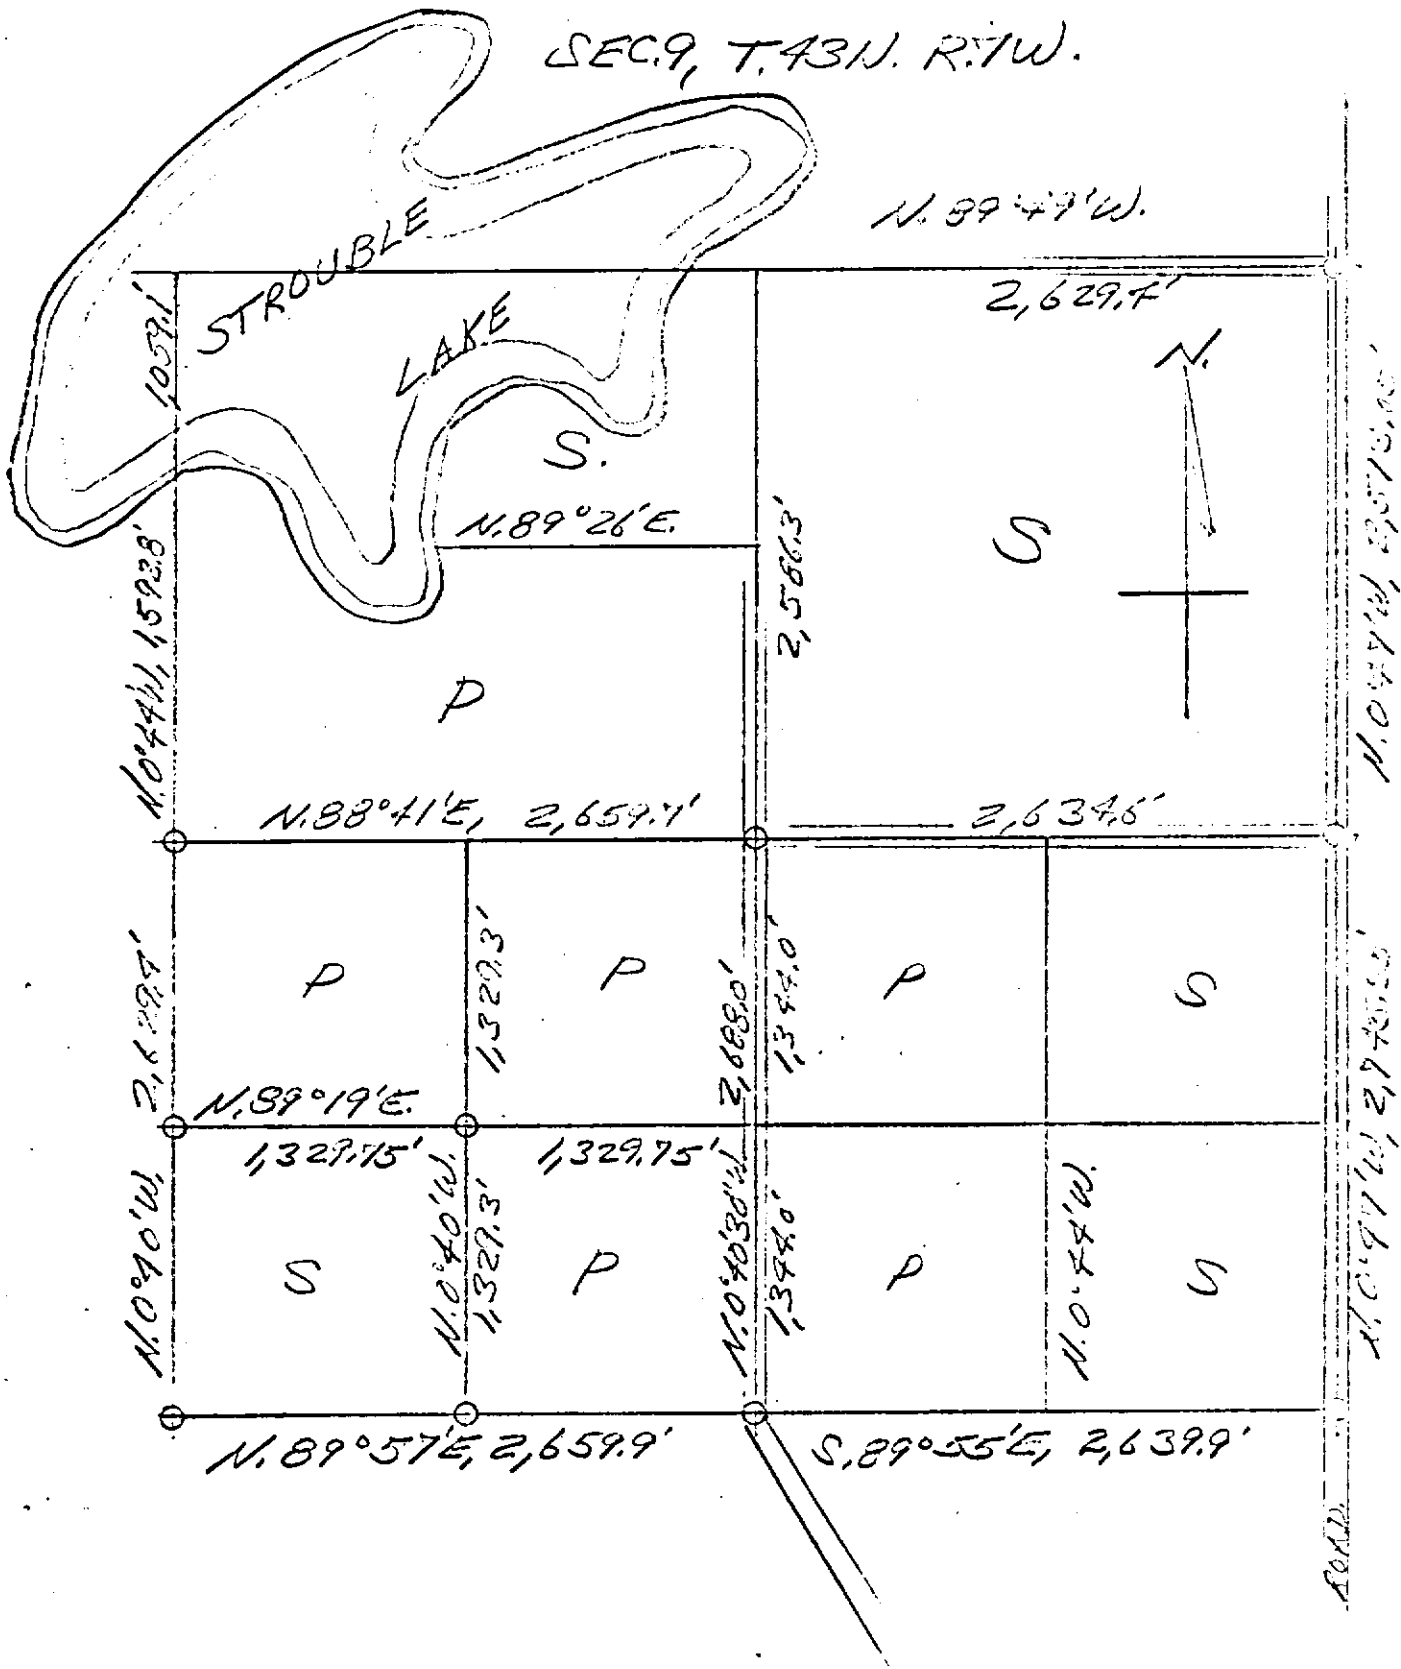

BDB
7/22/96