


SEC. 8, T.43N. R.7W.

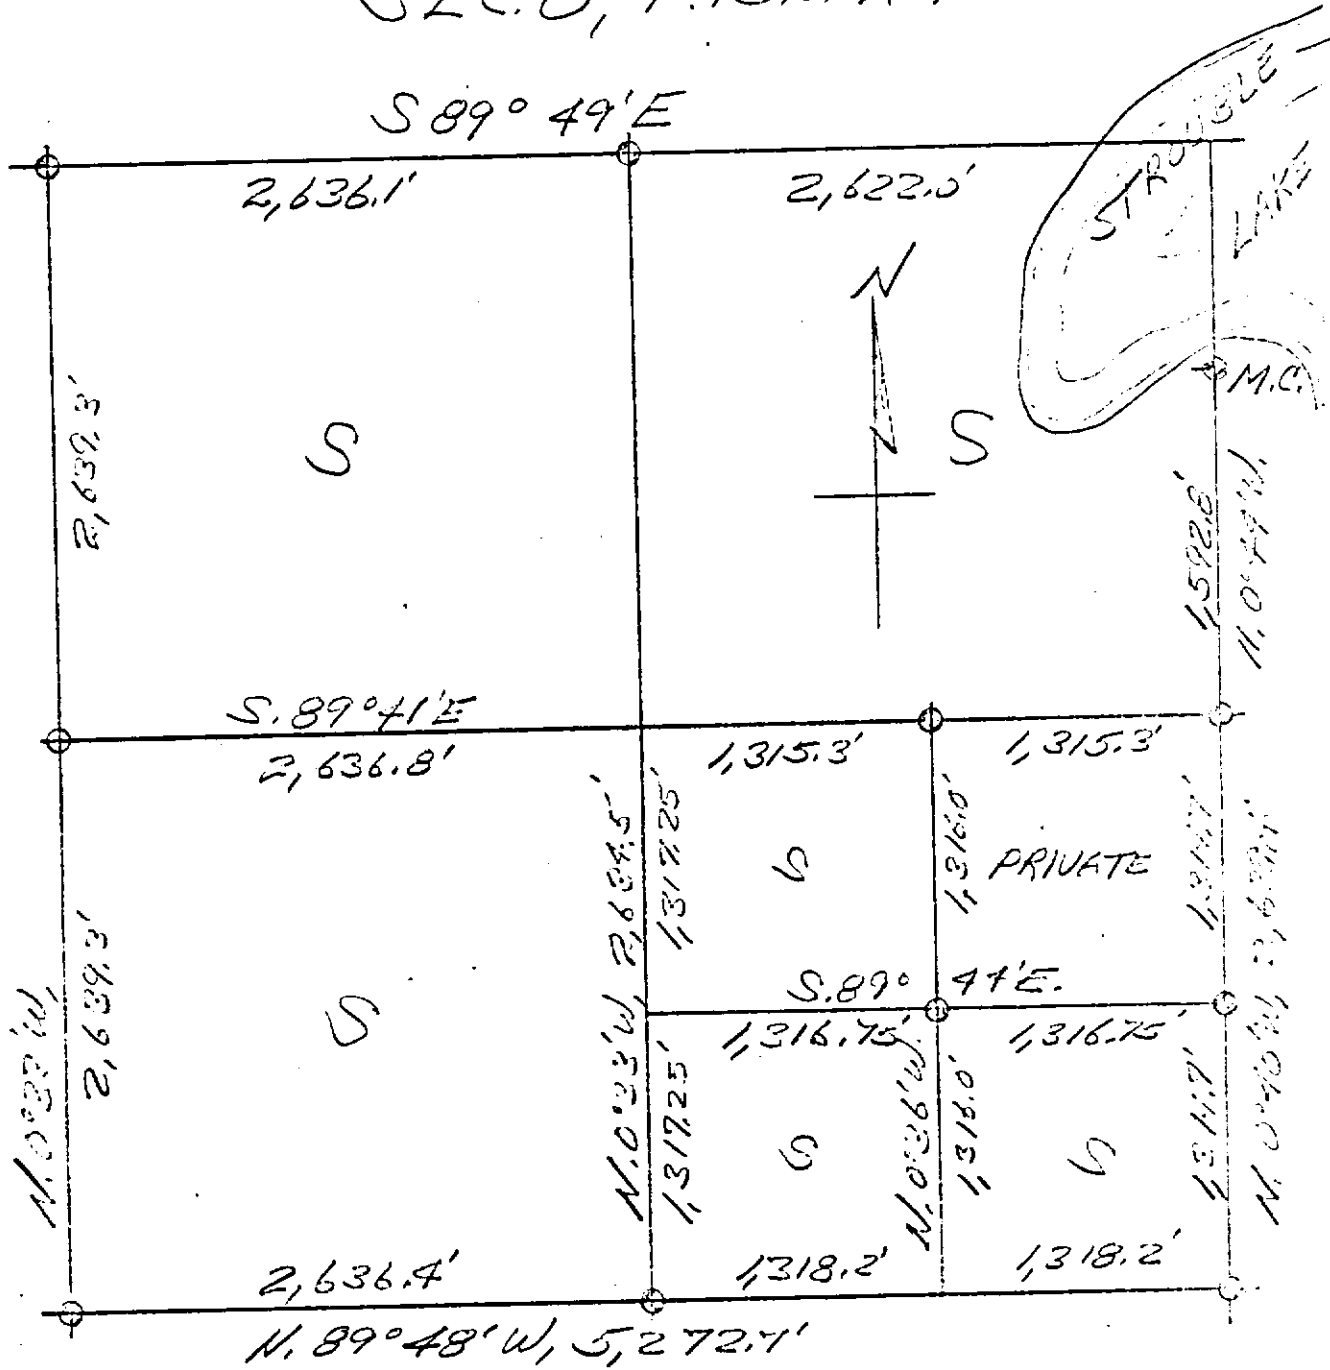

BDR
9/23/76.