

MICHIGAN  
DEPARTMENT OF CONSERVATION  
FORESTRY DIVISION

# LAND CORNER RECORD

T. 43-44 N.R. 7W


Mackinac COUNTY

DESCRIPTION OF CORNER Section Corner common to Secs. 1-2-35-36

CORNER MONUMENT 1" Pipe with 4" Aluminum Cap

DATE MONUMENT PLACED AND WITNESSED 3/18/64 with M. Burhis, Forestry Aide

WITNESSES TO CORNER..... 3" B. Spruce (S36NBT) N69°E 34½ Lks.

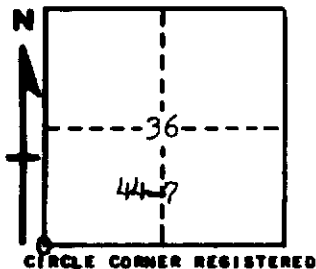

AND

**DESCRIPTION IN DETAIL AS TO HOW CORNER WAS LOCATED AND IDENTIFIED OR RESTORED.**

This Corner was re-established by Single Proportionate measure along Township Line from Section Corners 1 mile to East and West. Found no evidence of Original Corner.

**SURVEYOR'S SEAL**

SIGNED *Billy D. Buckler* DATE 8/4/1964  
BILLY D. BUCKLER  
REGISTERED LAND SURVEYOR