

MICHIGAN
DEPARTMENT OF CONSERVATION
FORESTRY DIVISION

LAND CORNER RECORD

T. 43 N.R. 7 W

Mackinac COUNTY


DESCRIPTION OF CORNER Section corners for sections ^{19/20} 30/29

CORNER MONUMENT 1" Iron Pipe with 4" Aluminum Cap

DATE MONUMENT PLACED AND WITNESSED 12/22/66, Frank J. Bray

WITNESSES TO CORNER..... 9" Cedar (S19)(NBT) N 73° W, 26 Links

8" Cedar (S20)(NBT) N 05° E, 40 Links

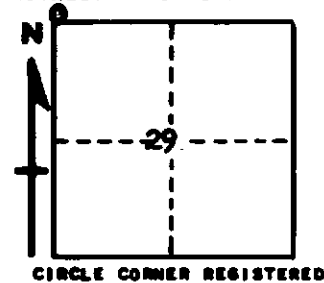

AND

CIRCLE CORNER REGISTERED

DESCRIPTION IN DETAIL AS TO HOW CORNER WAS LOCATED AND IDENTIFIED OR RESTORED.

This corner was reestablished by double proportioned measurement between section corners 1 mile to North, 2 miles to South and 1 mile to East and to West.

SURVEYOR'S SEAL

SIGNED Frank J. Bray DATE 7/31/67
REGISTERED LAND SURVEYOR